


TOWNSHIP 25 , RANGE 4E , W. M.

North

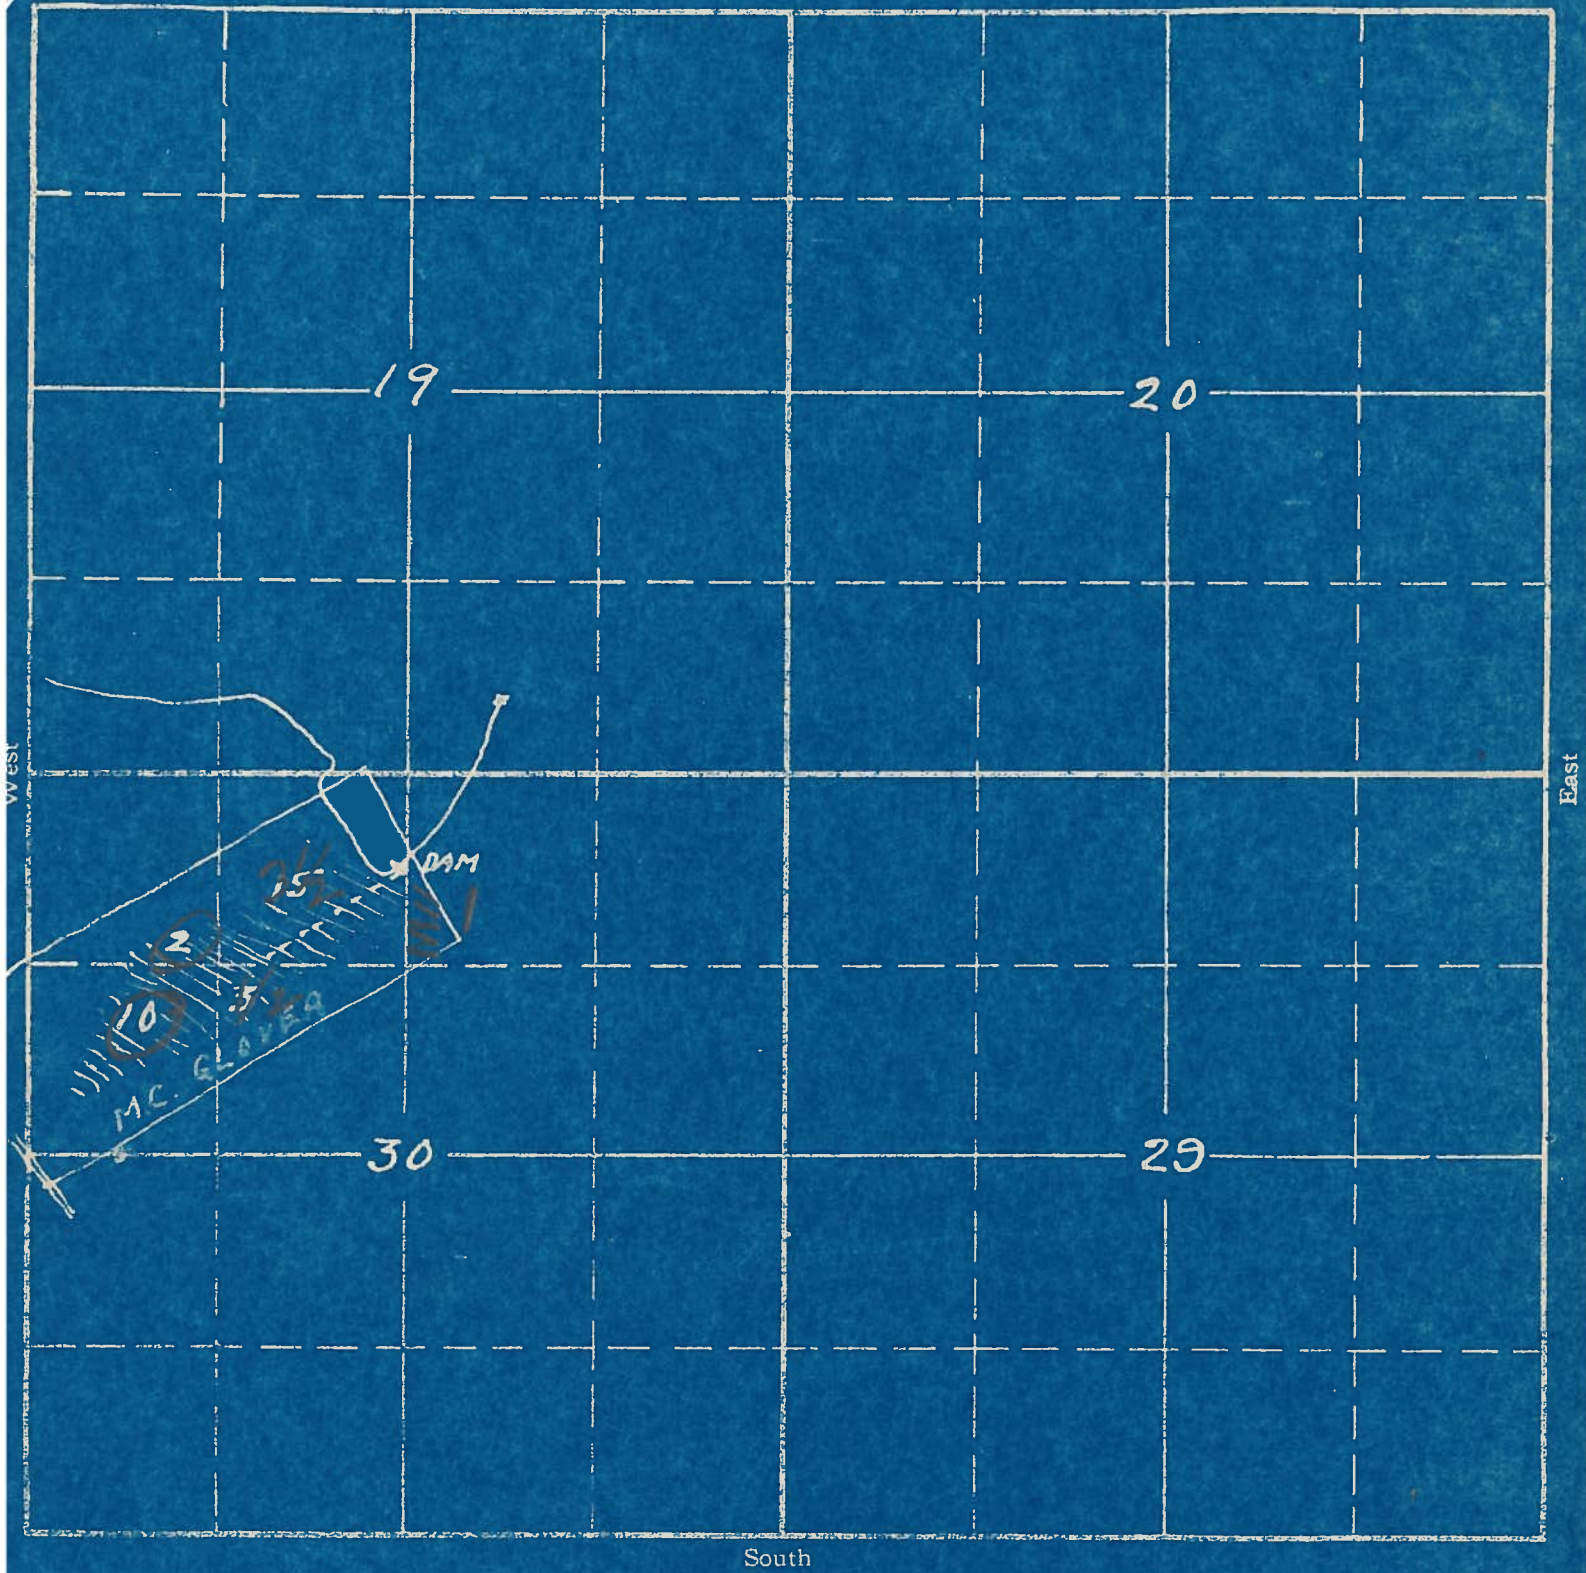

APPLICATION No. 14287
PERMIT No. 10313