


T17N-R14E W1/2

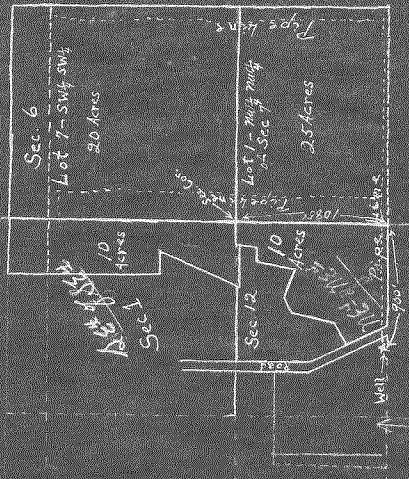

U-28
U-27

Handwritten notes or signatures.