


SECTION

5583

TOWNSHIP 15 , RANGE R12E, W. M.

North

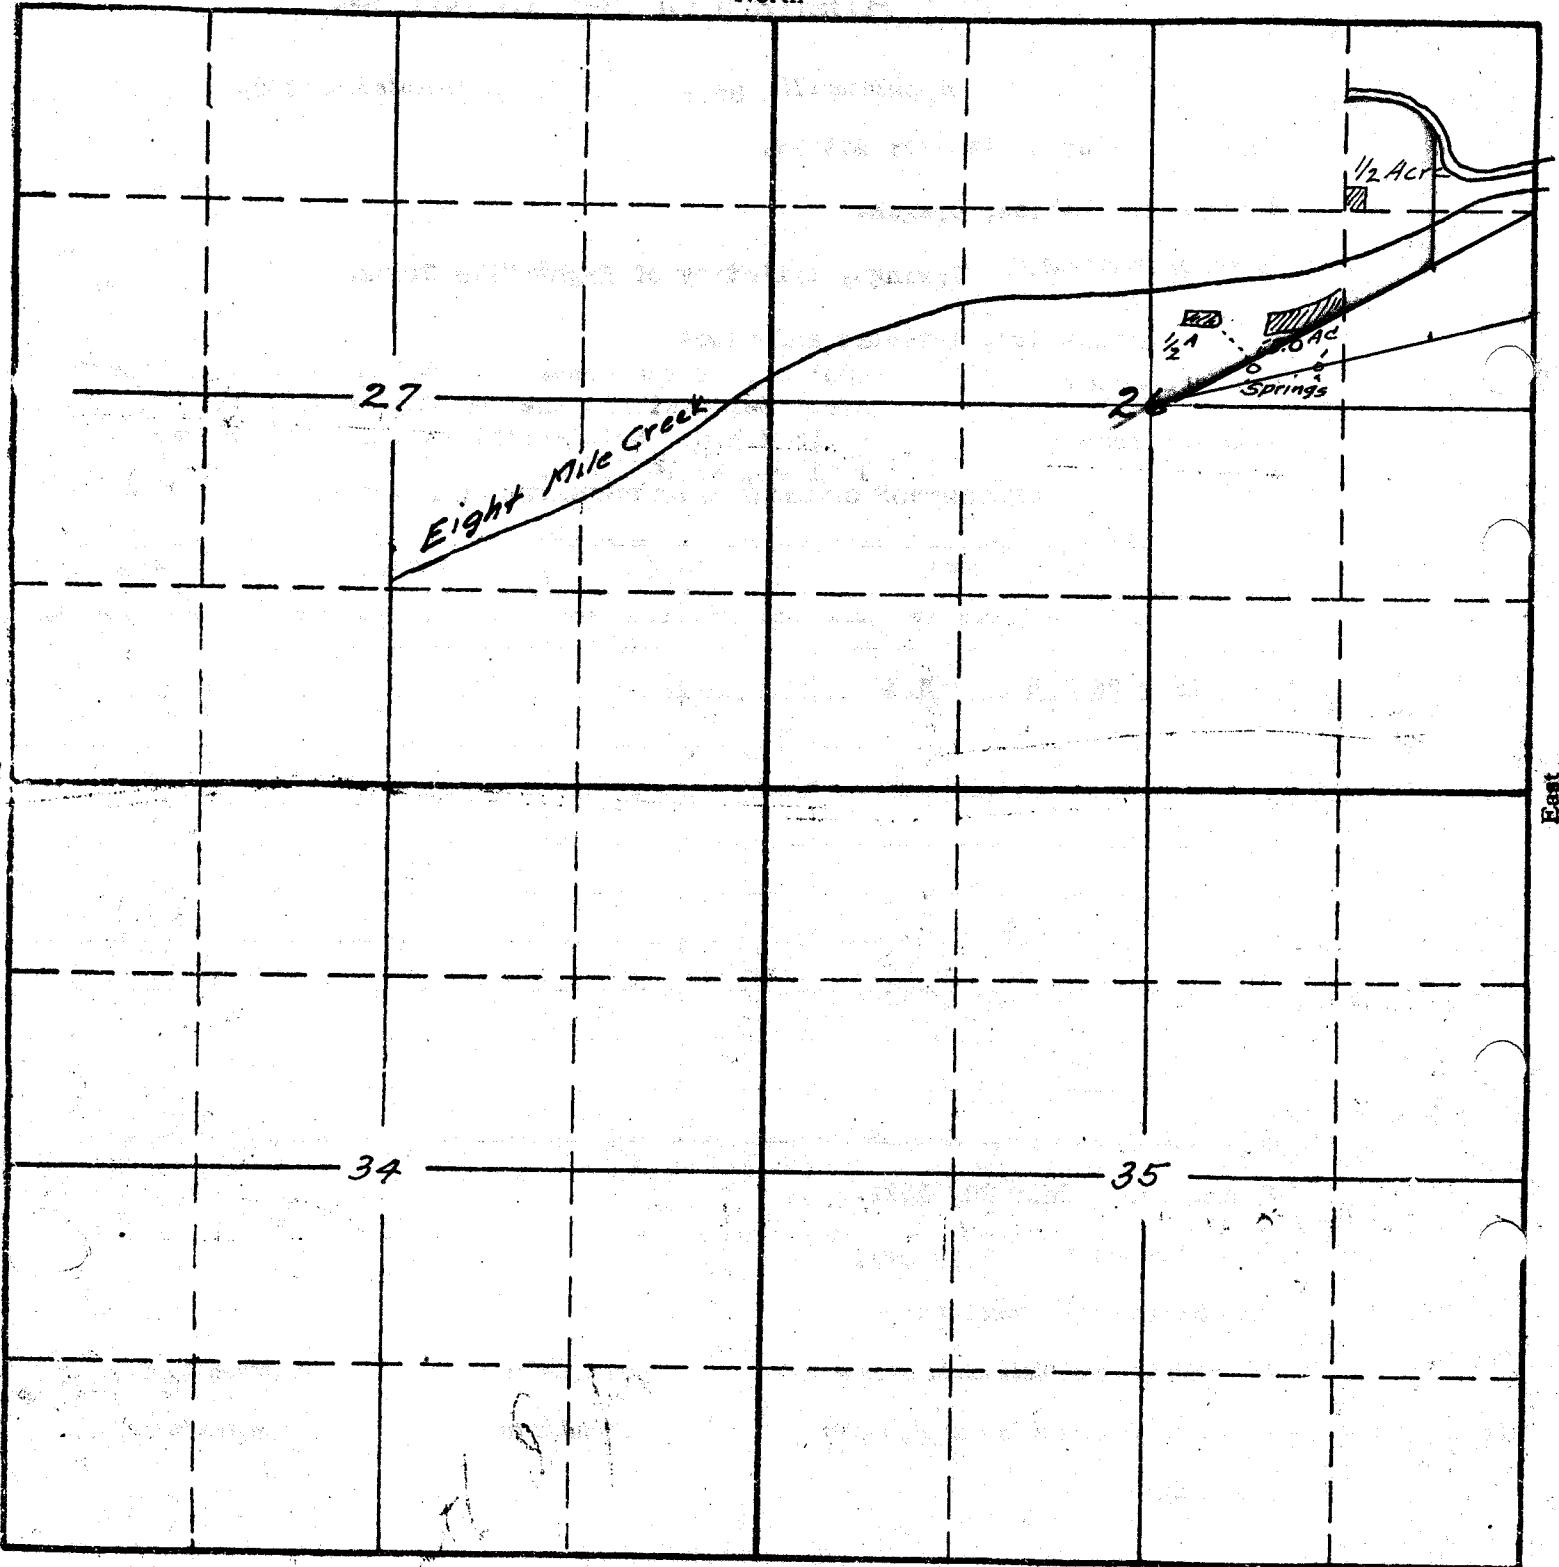

South

APPLICATION No. 8519

PERMIT No. 5583

