

I, G.H. Waggoner, of Eugene, Oregon do hereby certify that this map was made from notes taken during an actual survey made by me, on the 8th. day of April, 1926 and that it correctly represents the works described in the accompanying application, together with the location of streams and other ditches in the immediate vicinity


G.H. Waggoner  
Registered Professional Engineer  
Oregon. No 954  
Dated, Dec. 31st 1919

STATE ENGINEER  
RECEIVED

MAY 22 1926

SALEM.

OREGON

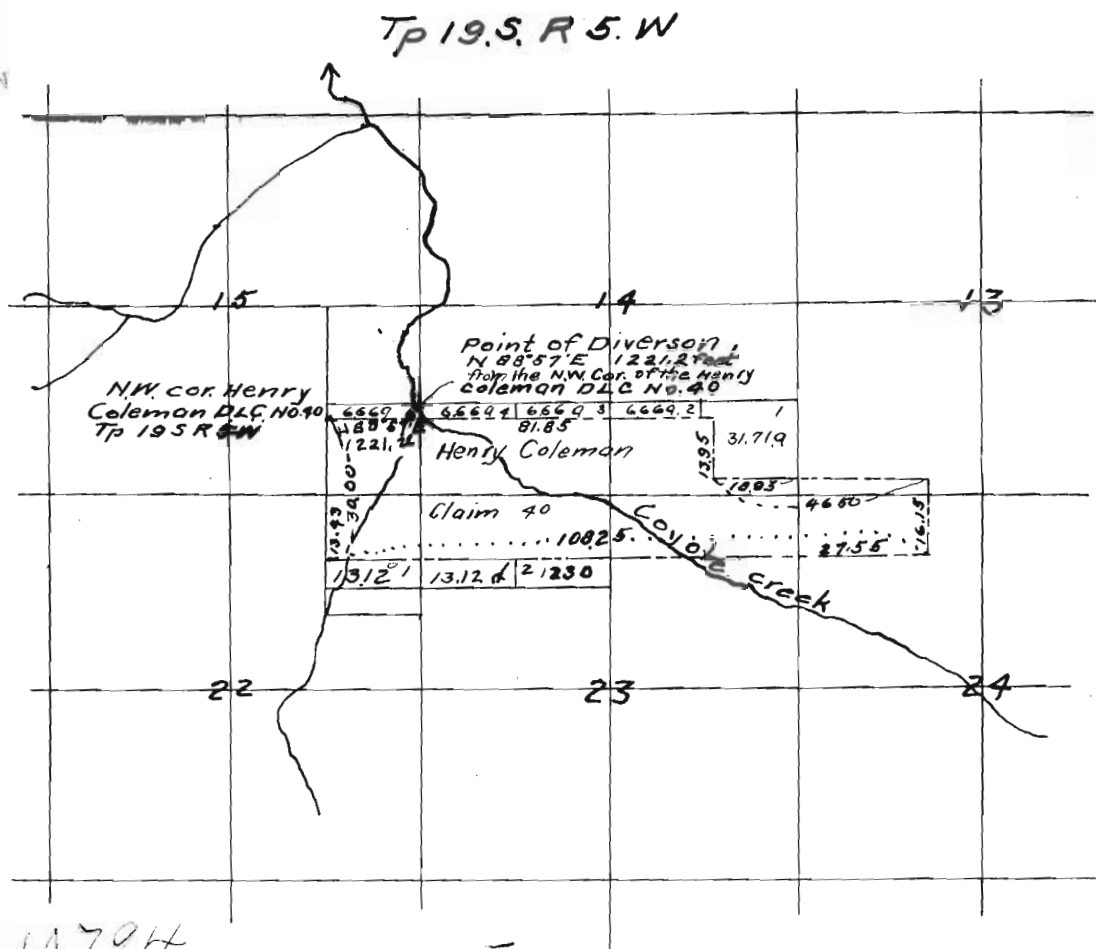

Application No. 10794  
Permit No. 7401