


12177

Sec.

Tp. 11S
R. 28E

Per 8575
10107

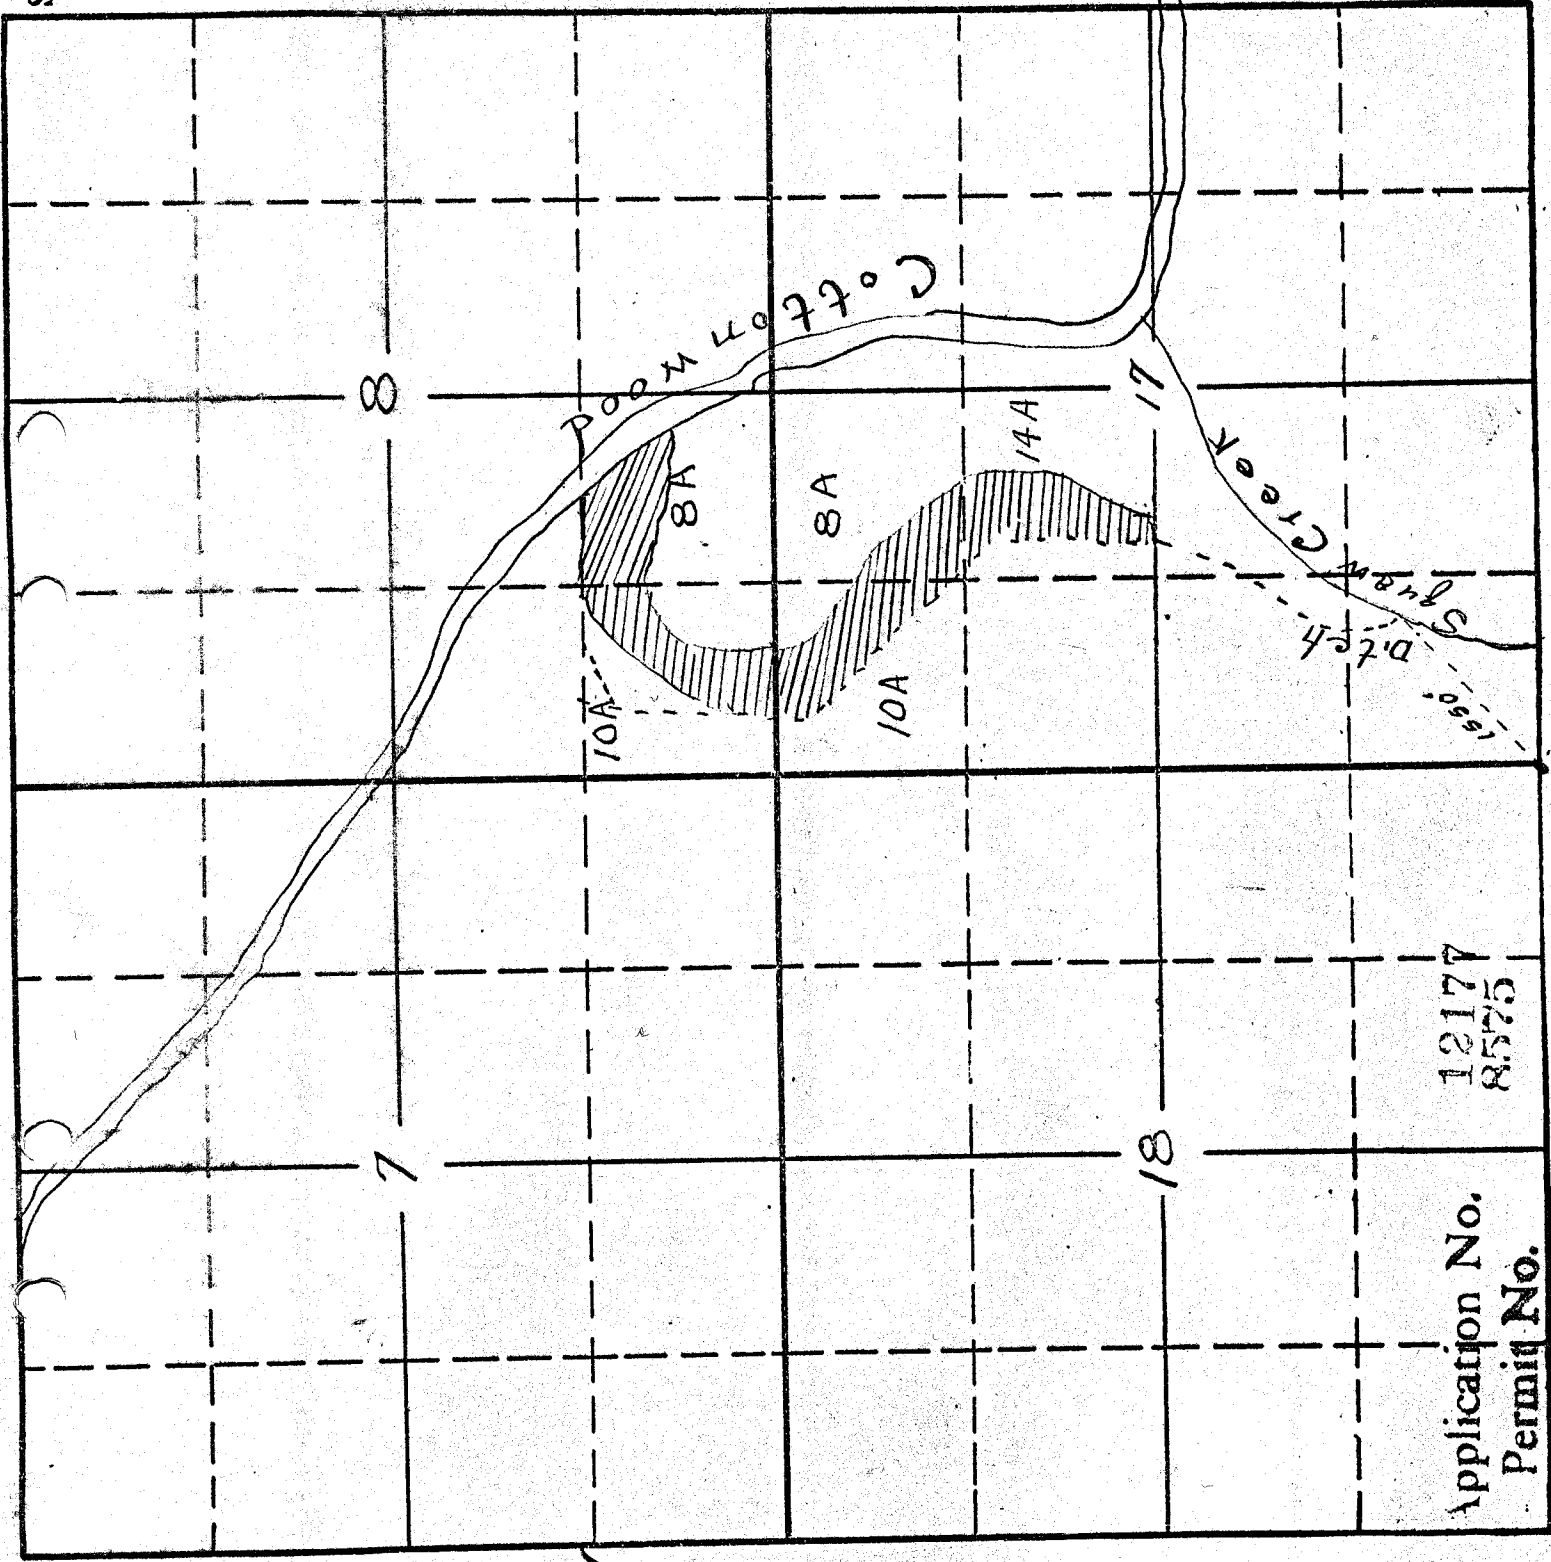

12177
8575

Application No.
Permit No.

*All maps attached
of property*