

SECTION

21

Per 10357

16124


TOWNSHIP 4 S., RANGE 31 E., W. M.

North

STATE ENGINEER
RECEIVED

SEP 15 1937

SALEM, OREGON

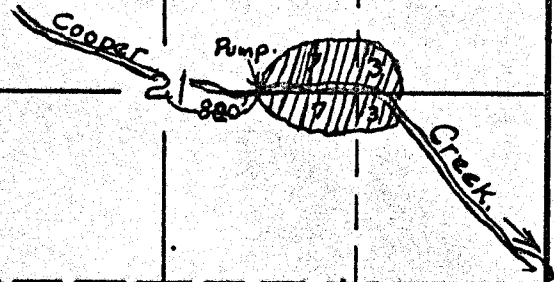

West

East

South

APPLICATION No. 14318
PERMIT No. 10357