

Sec. 21

Tp. 25

R. 26E

9639


10171

22

27

21

20

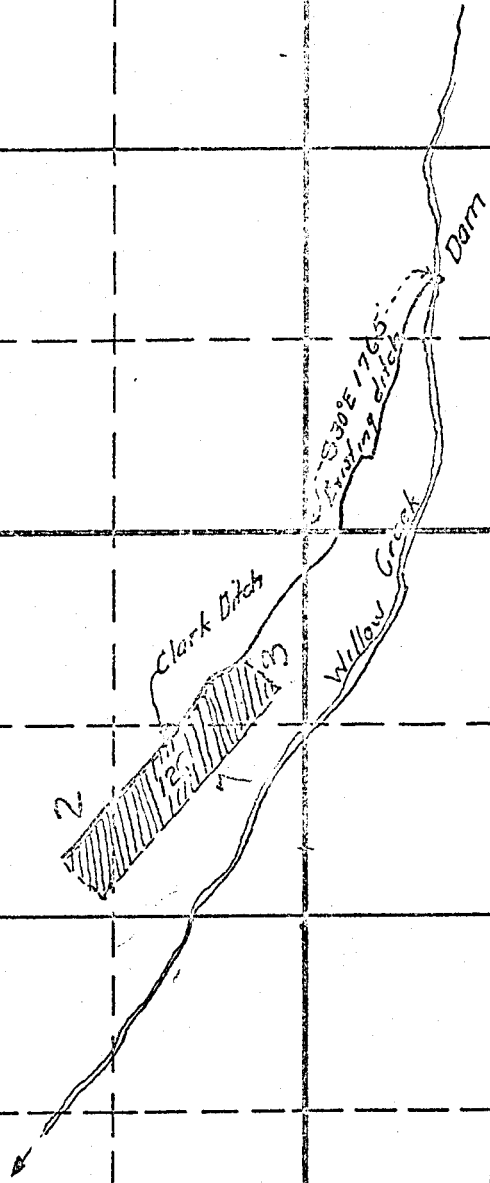

Application No. 13408
 Permit No. 9639