


T. 39S., R. 8 W. W.M.

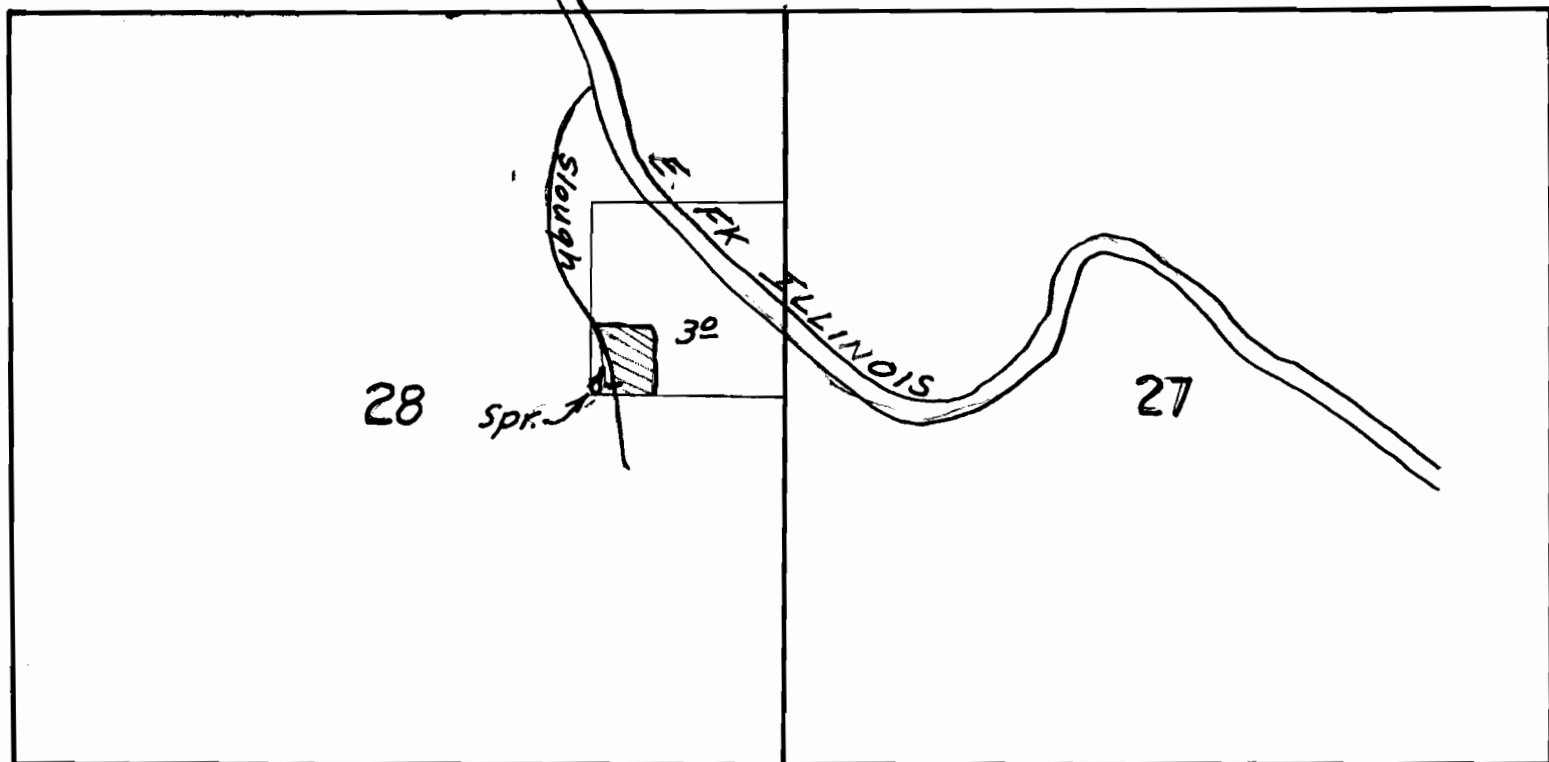

*Sketched from proof map*

*App 14214*


SECTION

27

28

TOWNSHIP 39 S, RANGE 8 W, W. M.

North

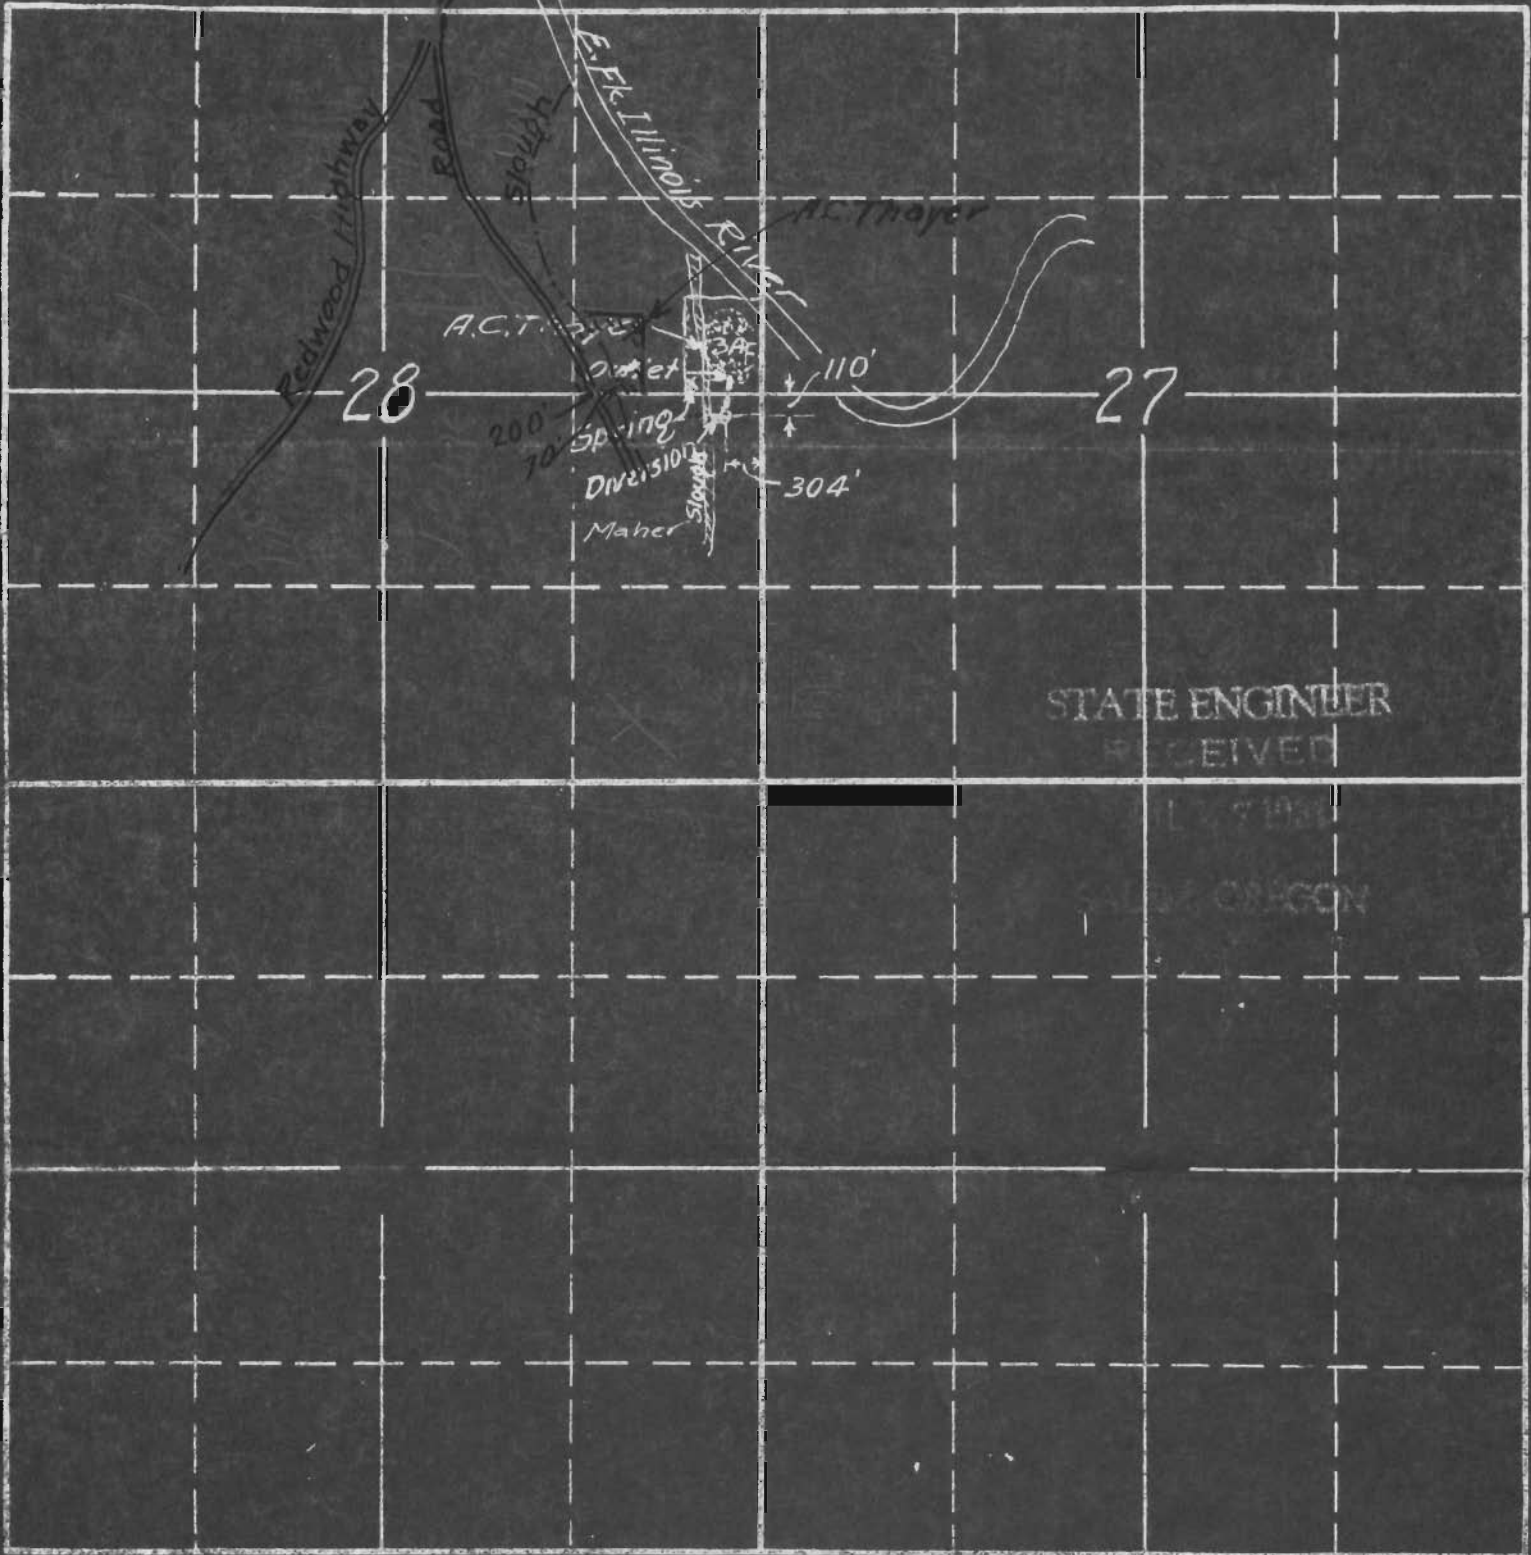

South

APPLICATION No. 14214

PERMIT No. 10271