

SECTION


4, S/2

9, N/2

P. 10352
10186

TOWNSHIP 6 S., RANGE 27 E., W. M.

North

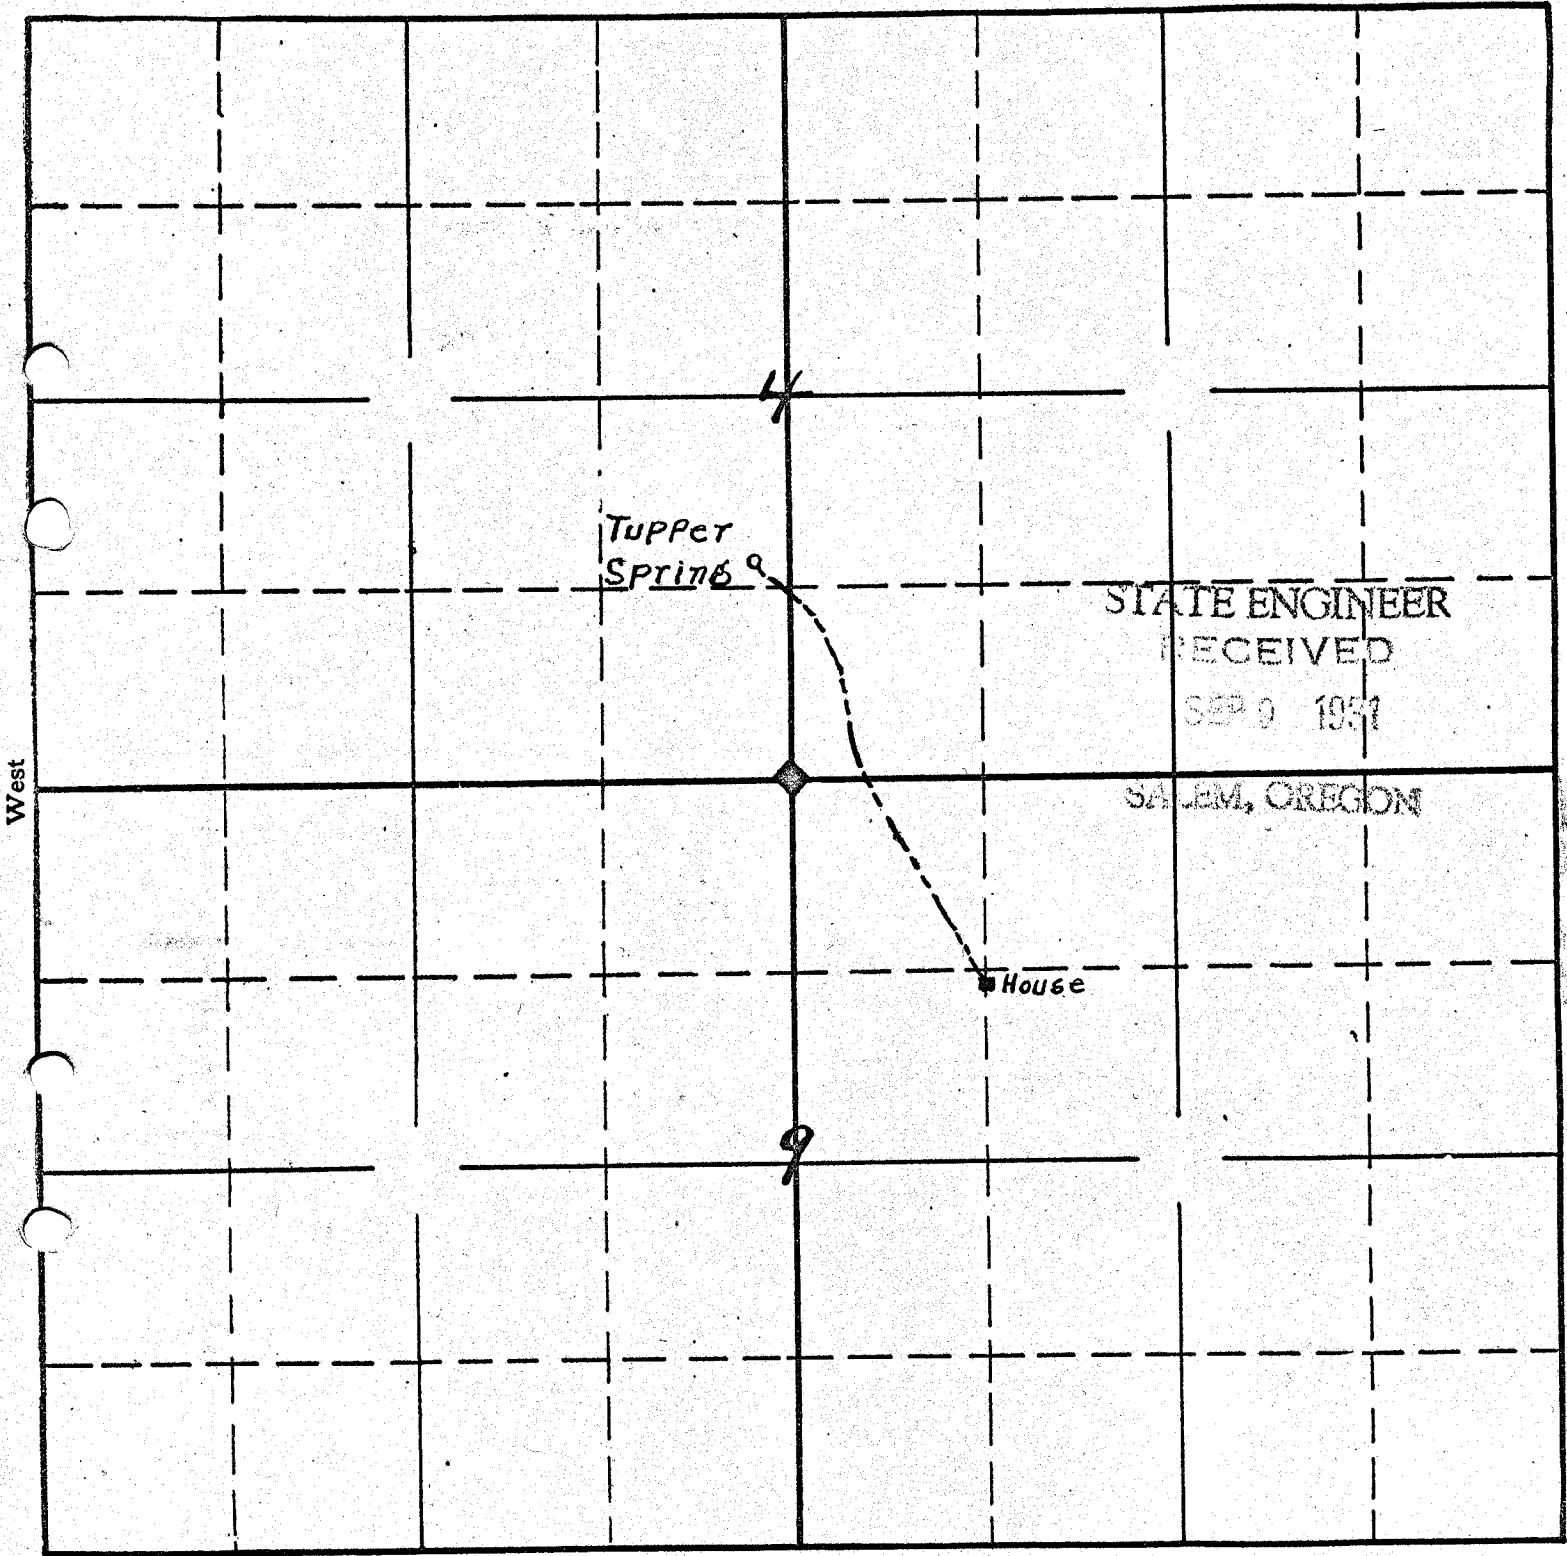

South

Scale 8 in. = 1 mile

APPLICATION No. 14303

PERMIT No. 10352