


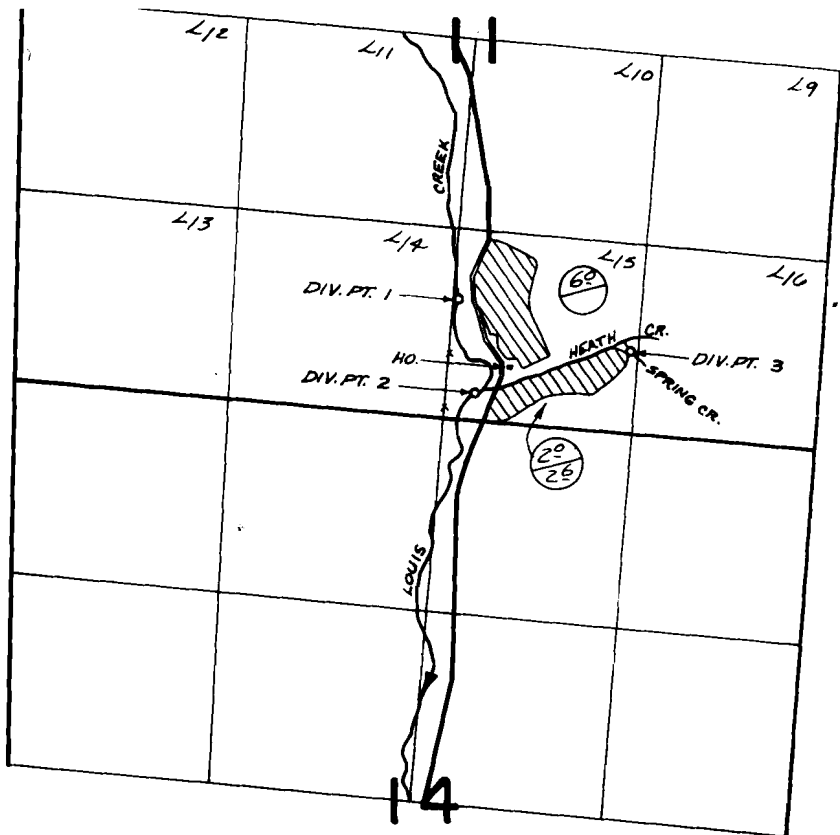

DIV. PT. 1, 800' N. & 110' E.; DIV. PT. 2, 170' N. & 220' E.; DIV. PT. 3, 460' N. & 1290' E.; ALL FROM S. 1/4 CORNER SECTION 11.

FINAL PROOF SURVEY UNDER



SUPPLEMENTAL

PRIMARY

Application No. 46347 Permit No. 34624
IN NAME OF

MELVIN K. GLASS

Surveyed JUNE 20 1974, by D. NORBY

MAP USED