


of irrigation ditches and
acreage of land under ditches
on the Ben. F. Bare place, in
Section 9, T. 6 S., R. 20 E., W. M.

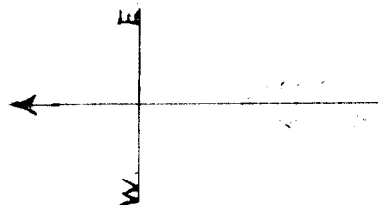


Var. 2202

Scale 1 - 200

cor. on East Bay section.

I, A. J. V. Hitchman, of Fossil.

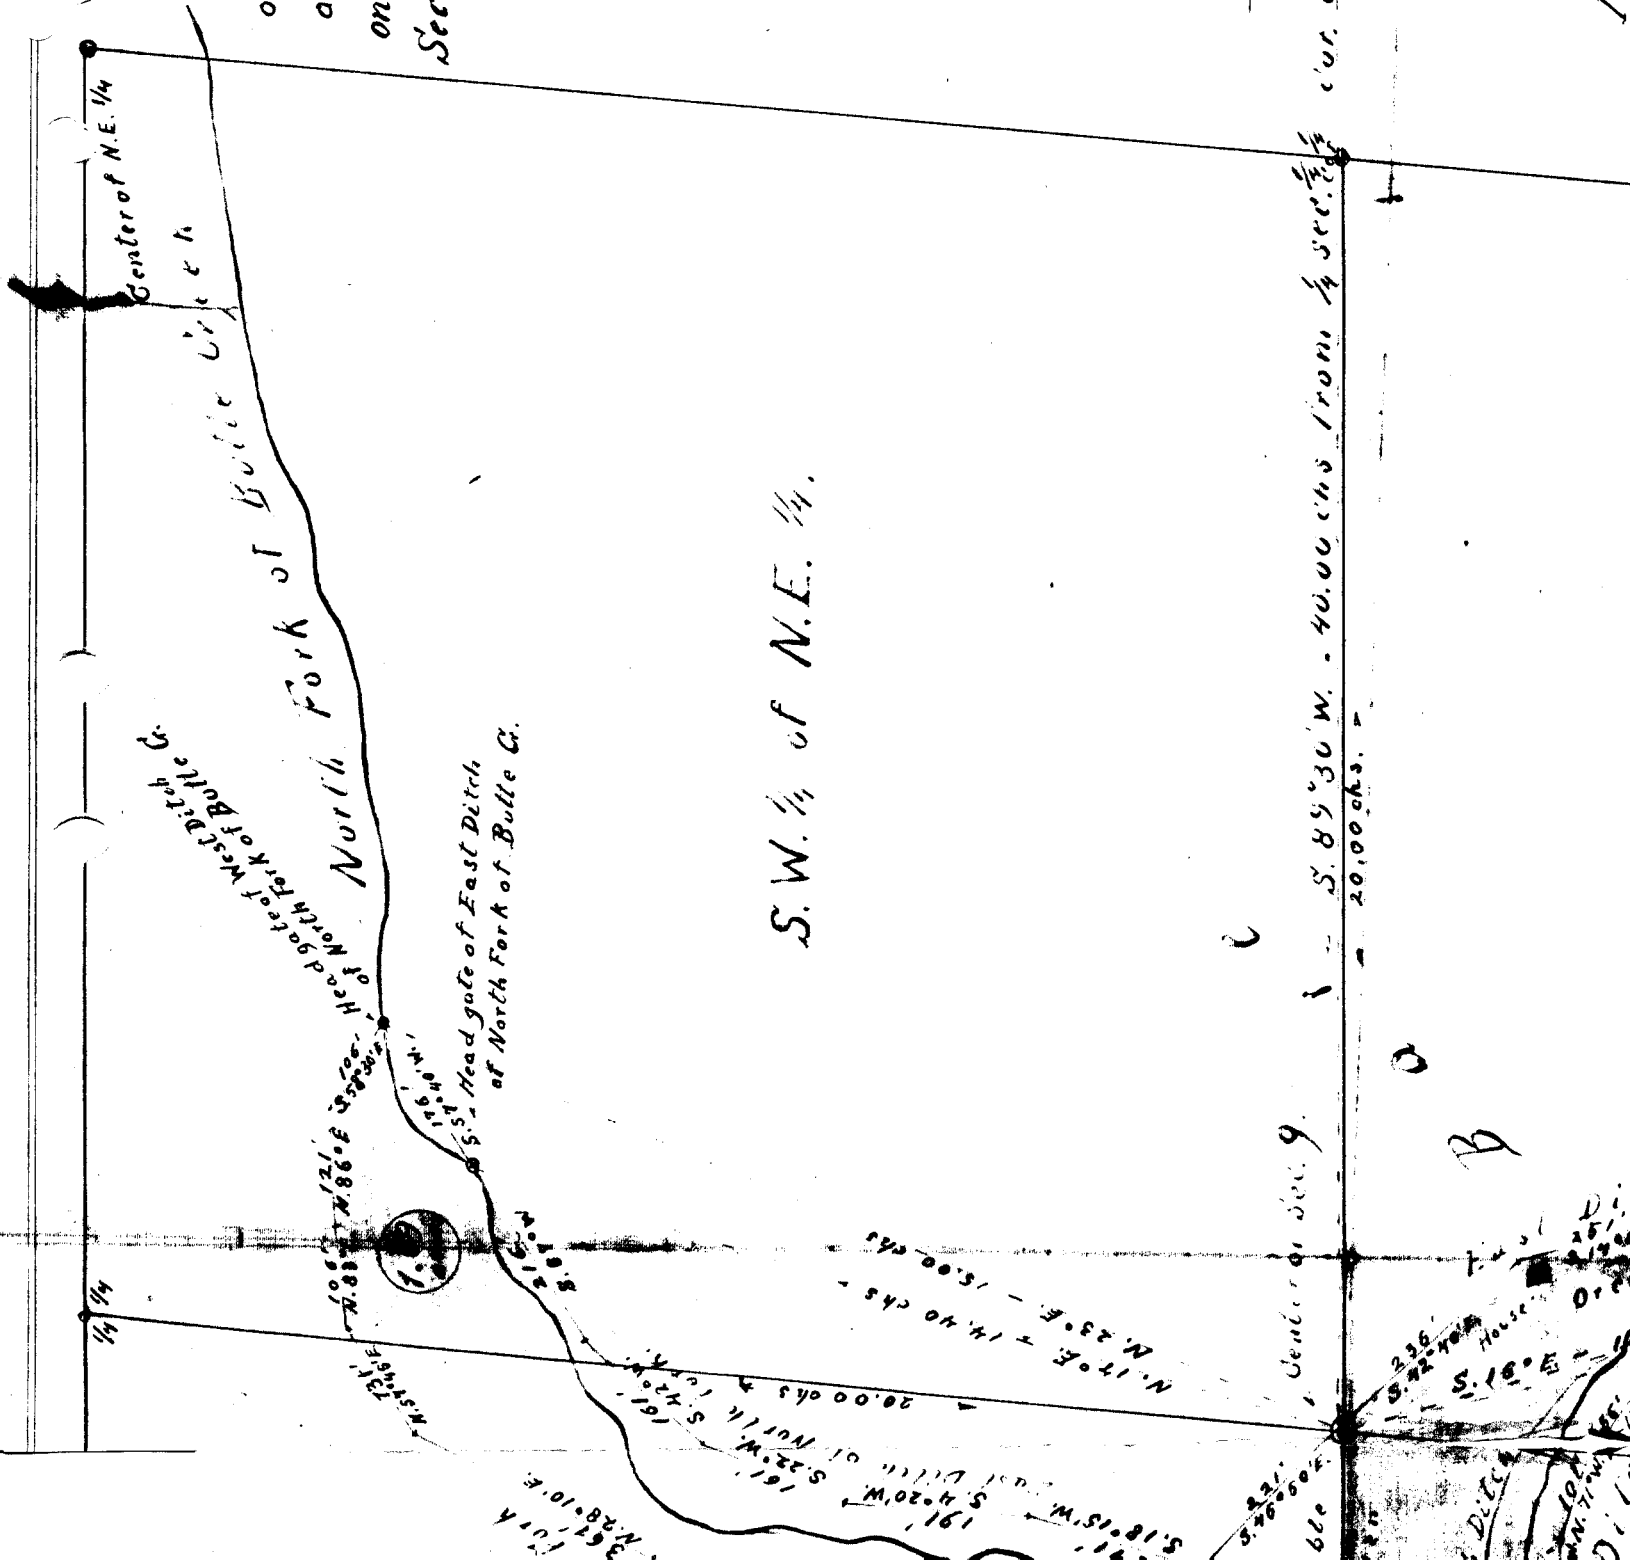

Scale 1' = 200'

Section on East Bay section 4.

I, H. H. F. Armstrong, of Fossil, Oregon do hereby certify that this map from notes taken during an actual survey made by me on May 29th 1910, and that it correctly represents the works described in the accompanying application, together with the location of streams and other ditches in the immediate vicinity, and has written thereon the area in each smallest legal subdivision which it is proposed to irrigate.

H. F. L. Hildreth

Surveyor.

Application # 607.

Permit # 245.

