


PLAN OF ED. PARKER'S LAND AND DITCH

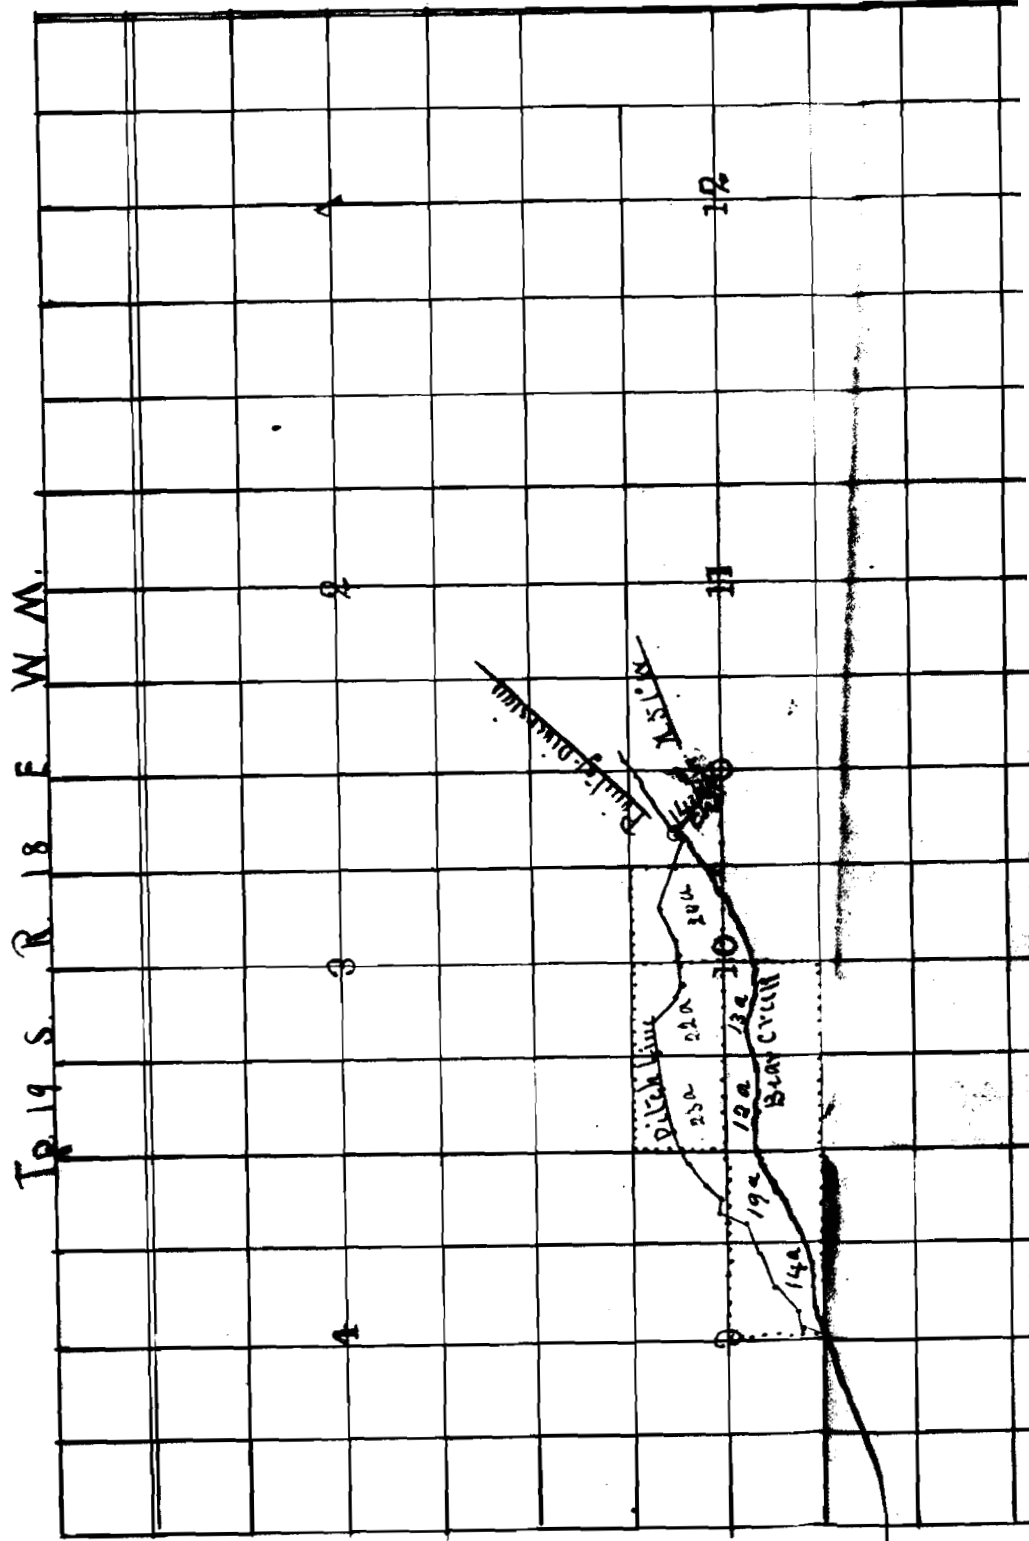

[illegible]

State of Oregon } ss.
County of Clatsop }

I, W. R. McFarland being first duly sworn depose and say, that, I am a surveyor by profession, and that on Oct., 14, 1910, I actually surveyed the ditch and irrigated land on this map, noted and indicated, and that the same is true and correct.

W. R. McFarland

W. P. McFarland

Subscribed and sworn to before me this 19th
day of Nov 1910.

M. E. Bink

Notary Public for Ore.

Application No. 1092
Permit No. 516

Scale 1 inch = 40 chs.