




# Range 24 E.W.M.

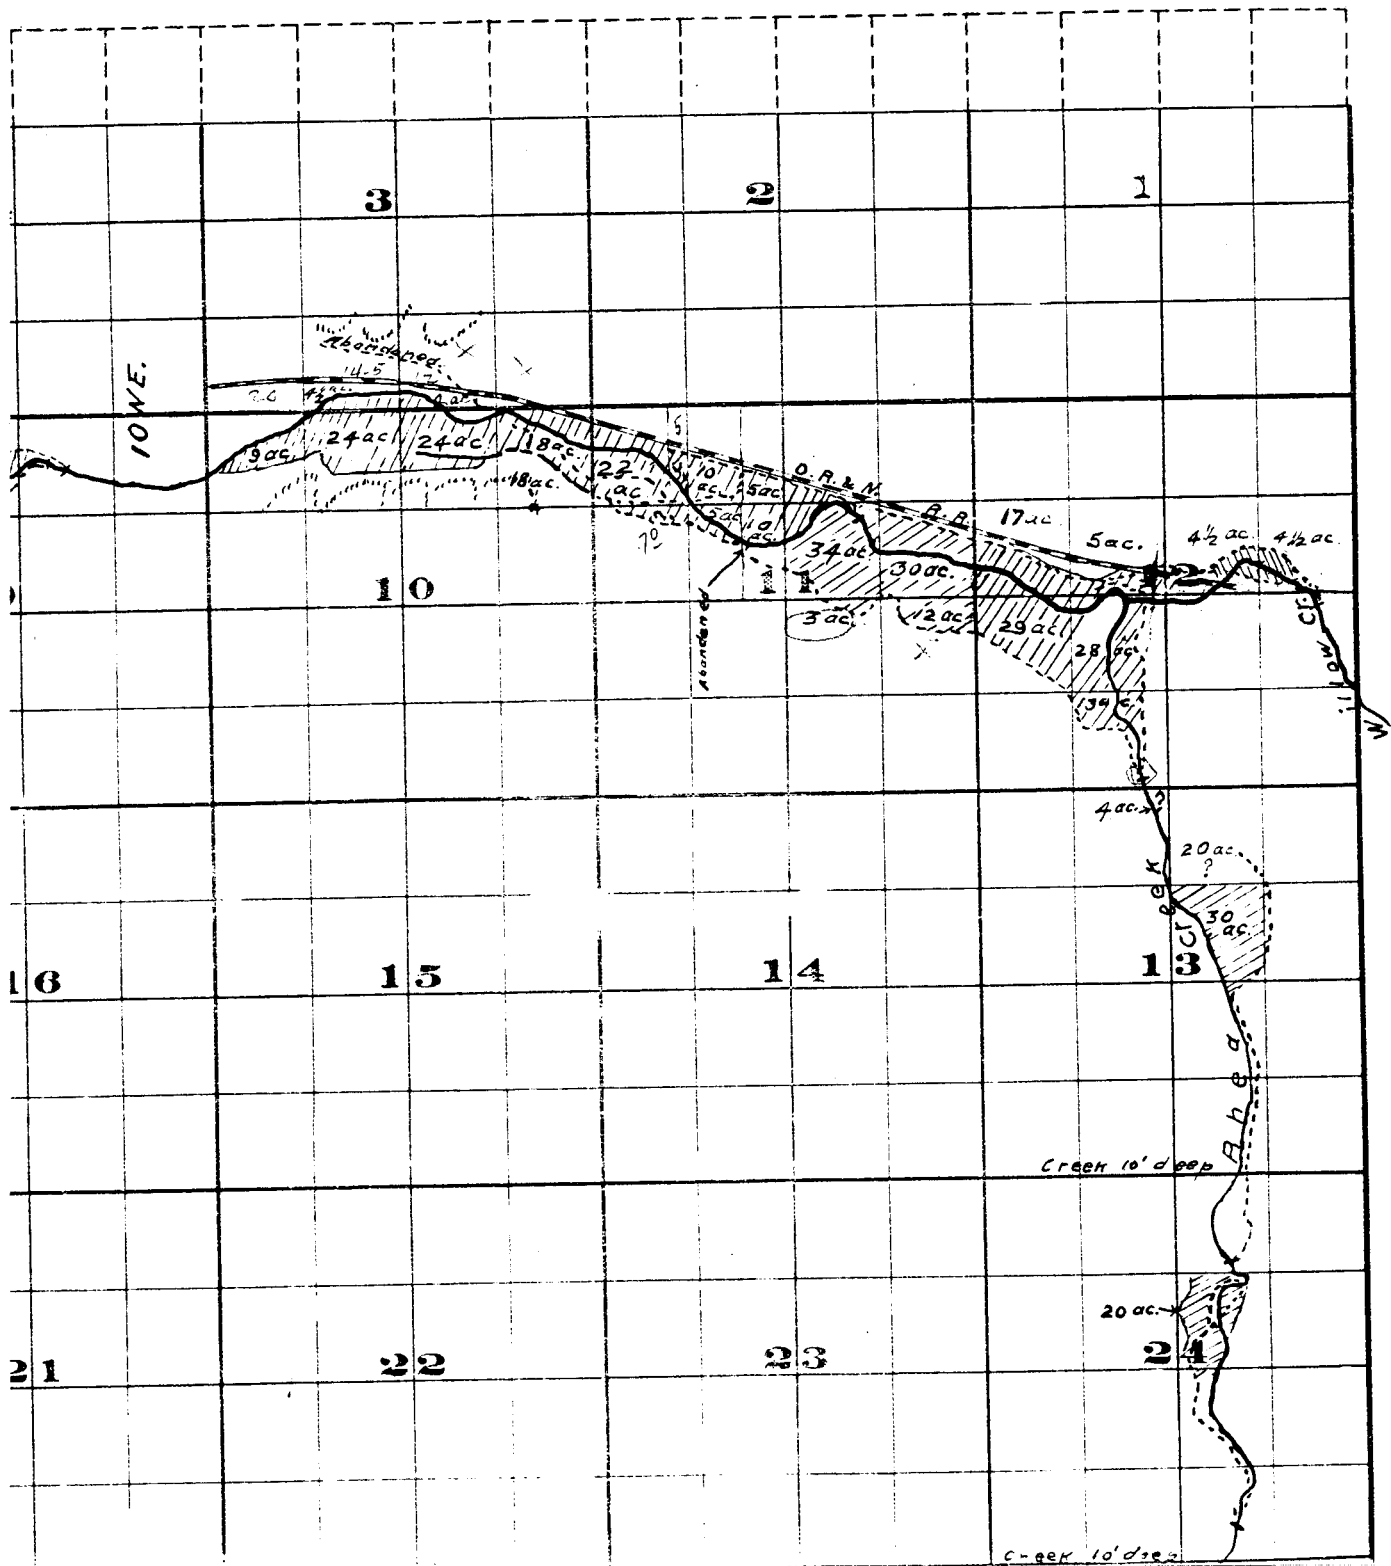

# Township 15. ,

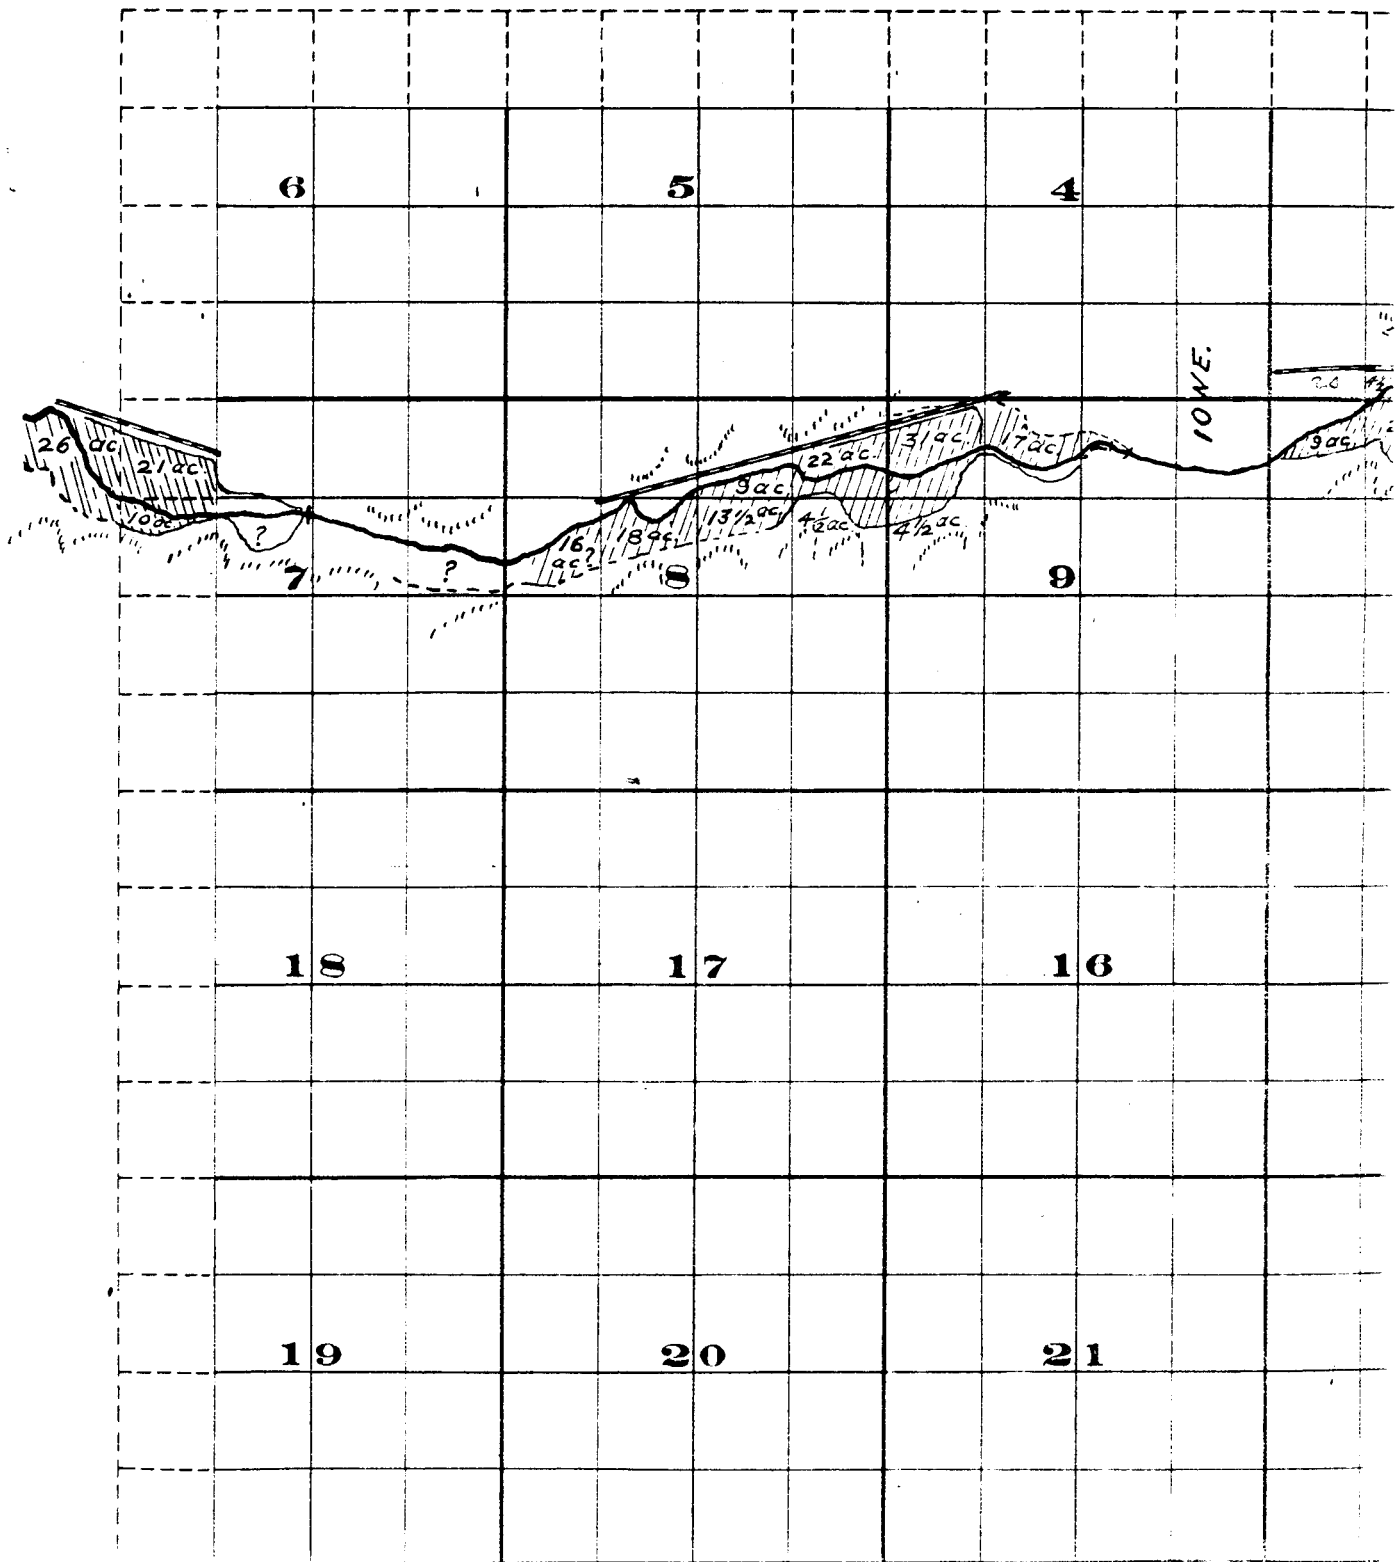

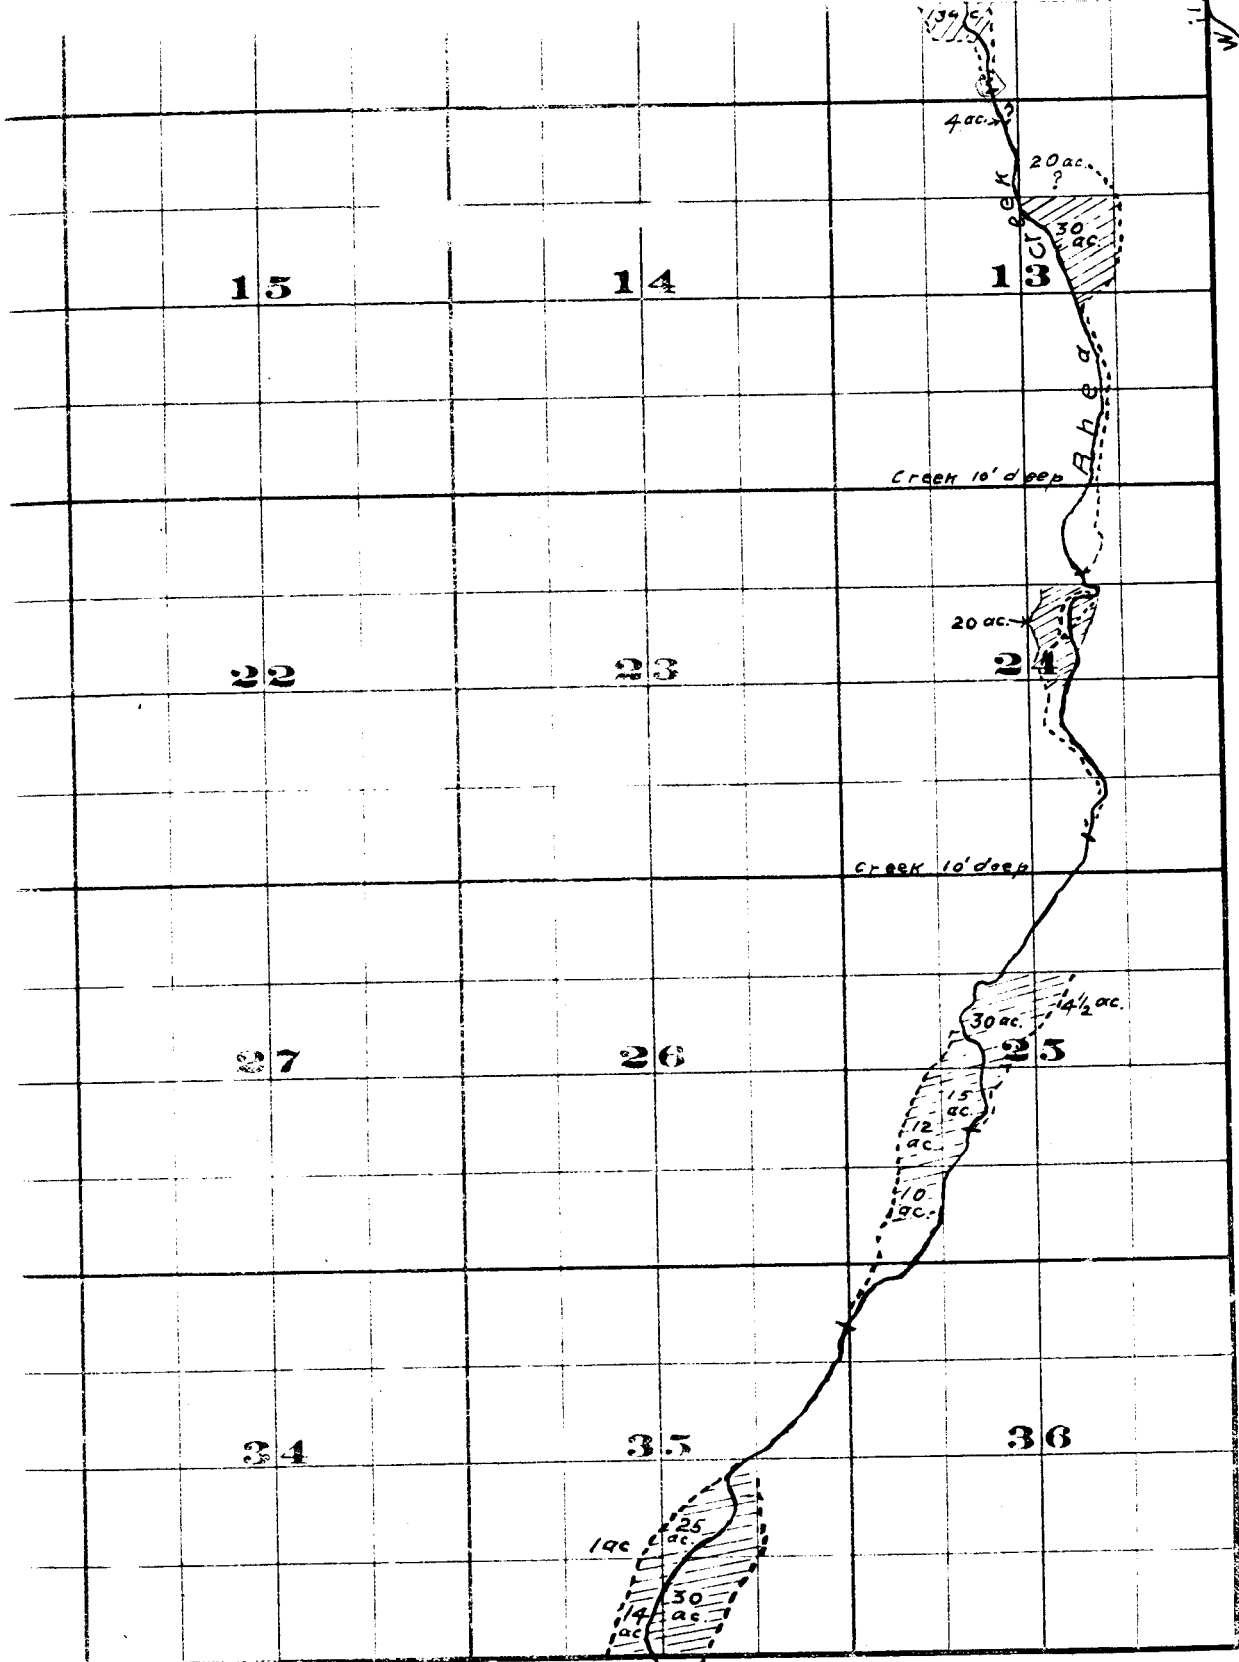


FROM OFFICE OF THE STATE ENGINEER, SALEM, OREGON

*Willow Creek Adjudication.*

1 S. 24 E

R. 10 W

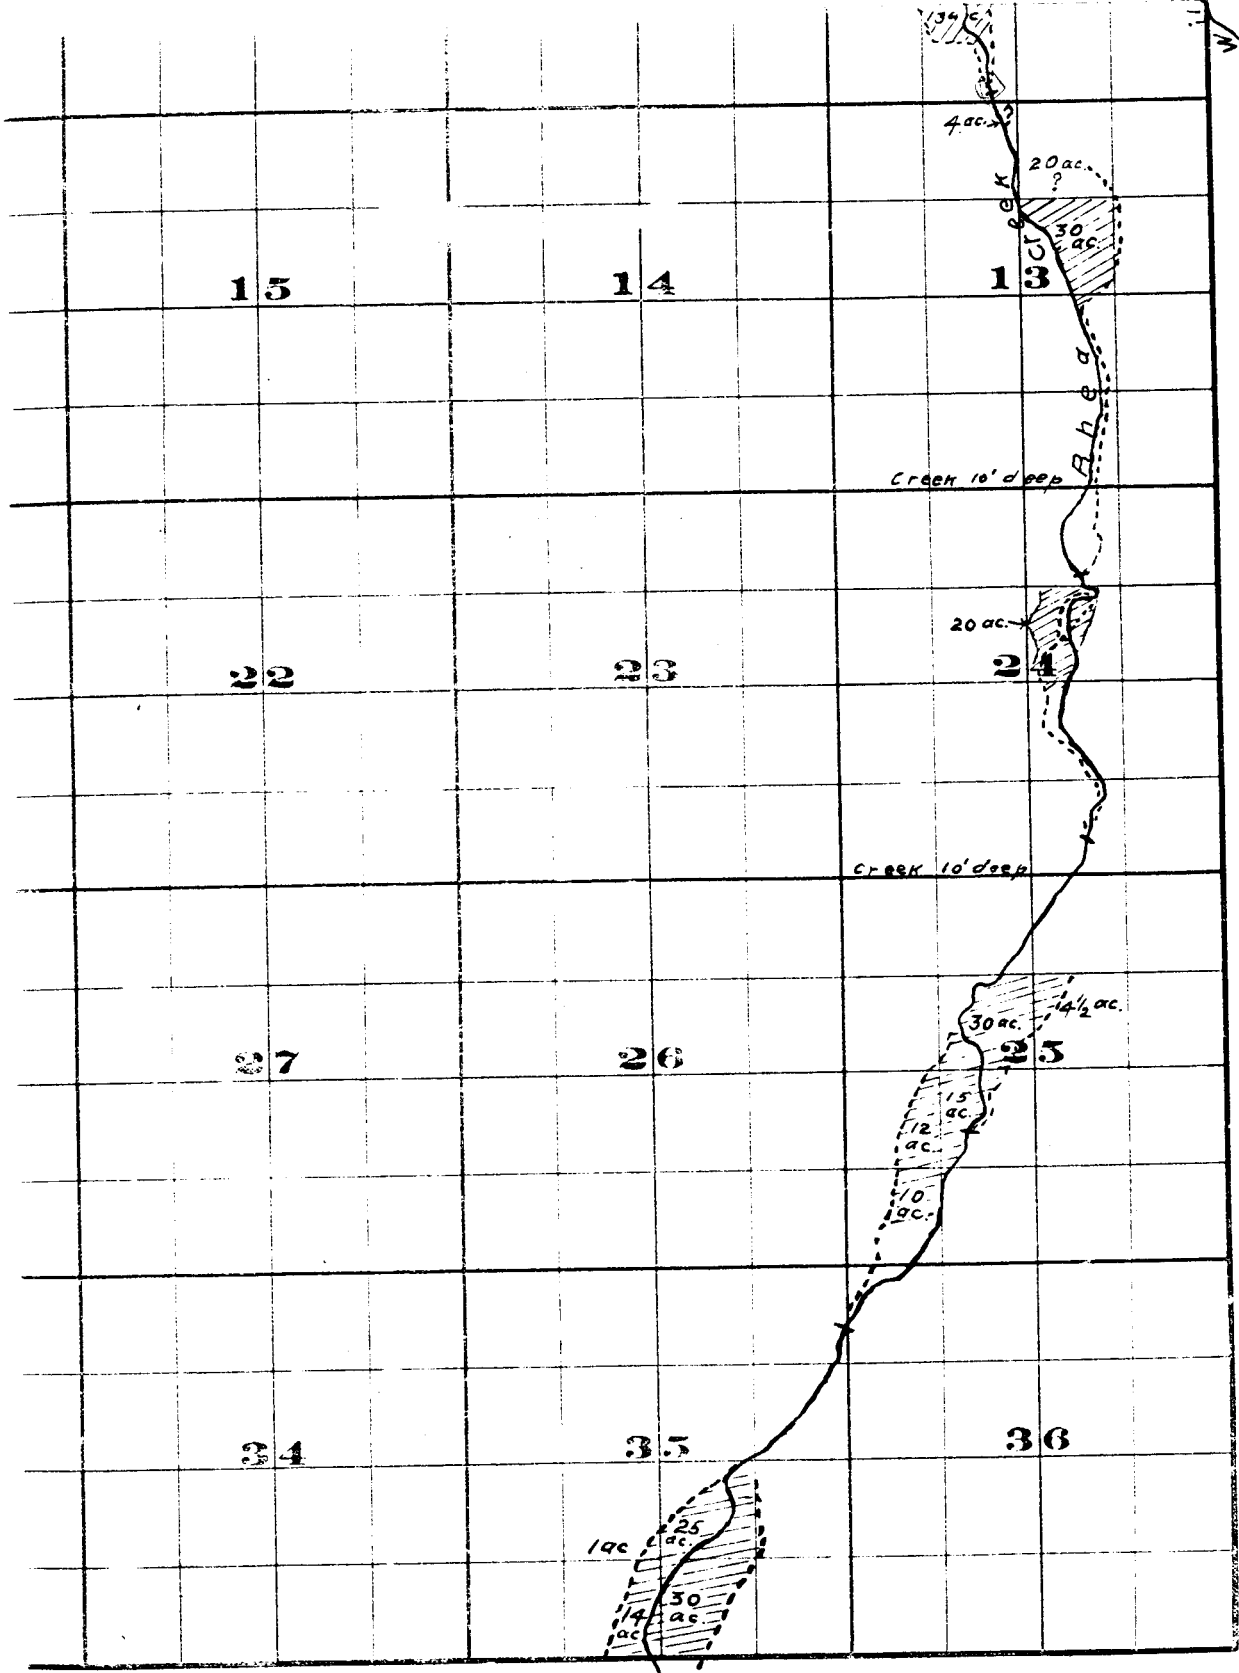

FROM OFFICE OF THE STATE ENGINEER, SALEM, OREGON

*Willow Creek Adjudication.*

1 S. 24 E

R. 1 W. 37 E