

UNITED STATES DEPARTMENT OF AGRICULTURE
FOREST SERVICE

MAP SHEET

Deschutes National Forest.

Division

District

4

Block

T. 15 S., R. 23 E.

W.

N.

Section


33

Quarter

SW 1/4 NW 1/4,
NW 1/4 SW 1/4.

Mapped by C. S. Congleton

Scale: 2 inches = 1 mile.

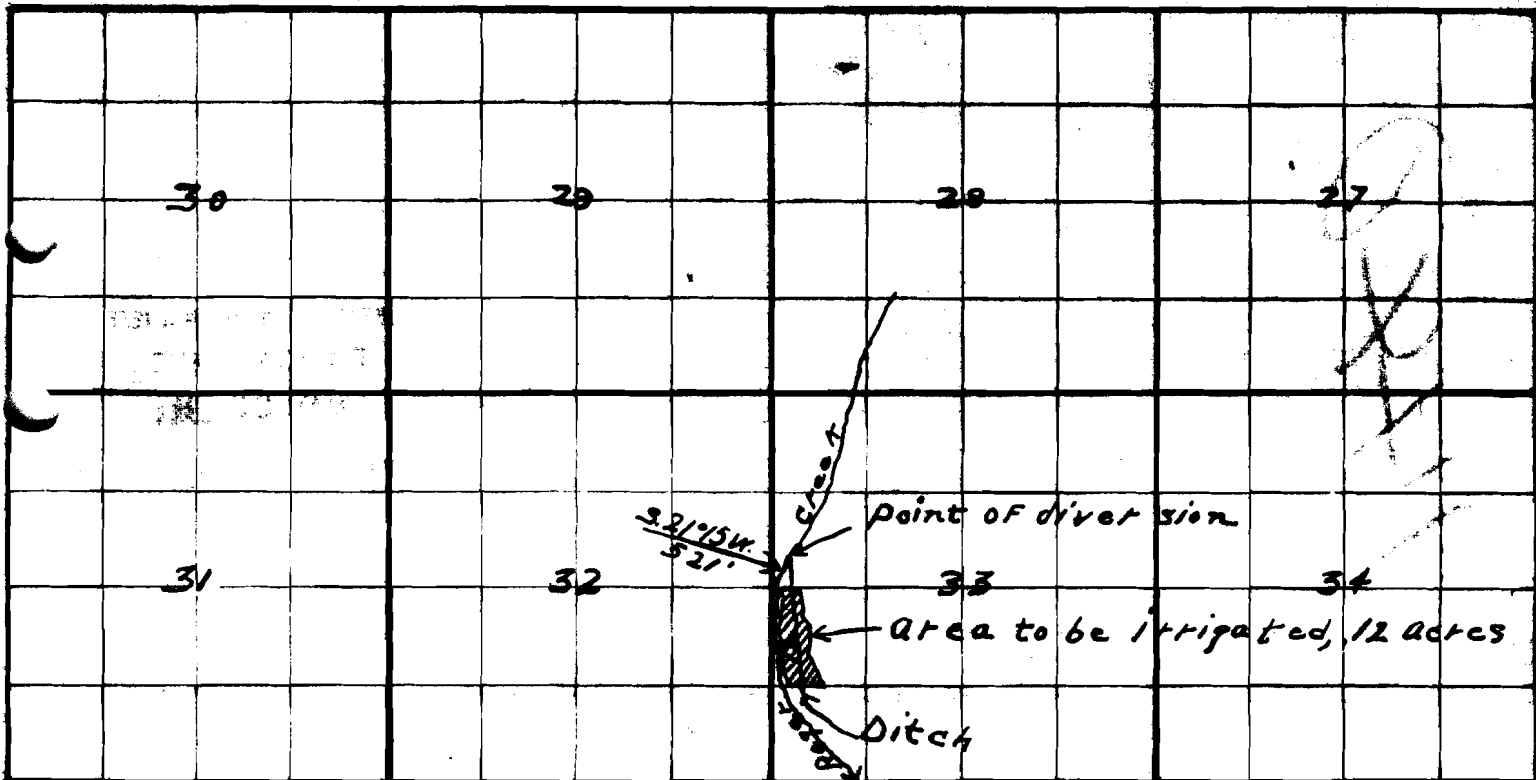

I, C. S. Congleton, of Pauline, Oregon, do hereby certify that this map was made from notes taken during an actual survey made by me on April 20, 1911, and that it correctly represents the works described in the accompanying application, together with the location of streams and other ditches in the immediate vicinity, and has written thereon the area in each smallest legal subdivision which it is proposed to irrigate.

OFFICE OF STATE ENGINEER

RECEIVED

MAY 20 1911

EATON, OREGON

C. S. Congleton
SurveyorApplication No. 1440
Permit No. 693