


Application No. 12182

Permit No. 8577

T4N-R10W

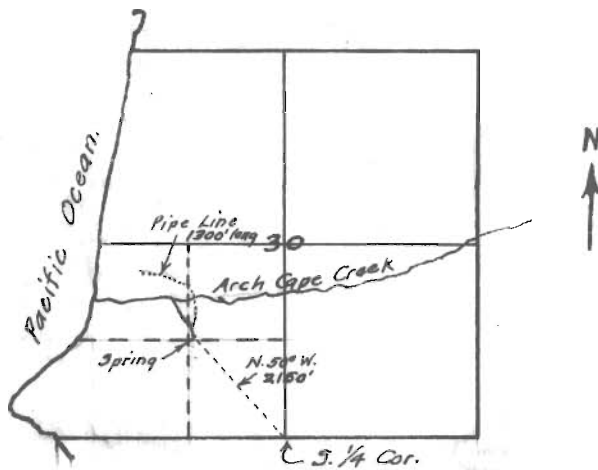

Map to accompany
application of
Sam H. Webb.

Scale $\frac{1}{2}$ " = 1 mi. 7/10 '28.

Beasley & Stock, Engrs.
421 Ch. of Com. Bldg.