



522. 24

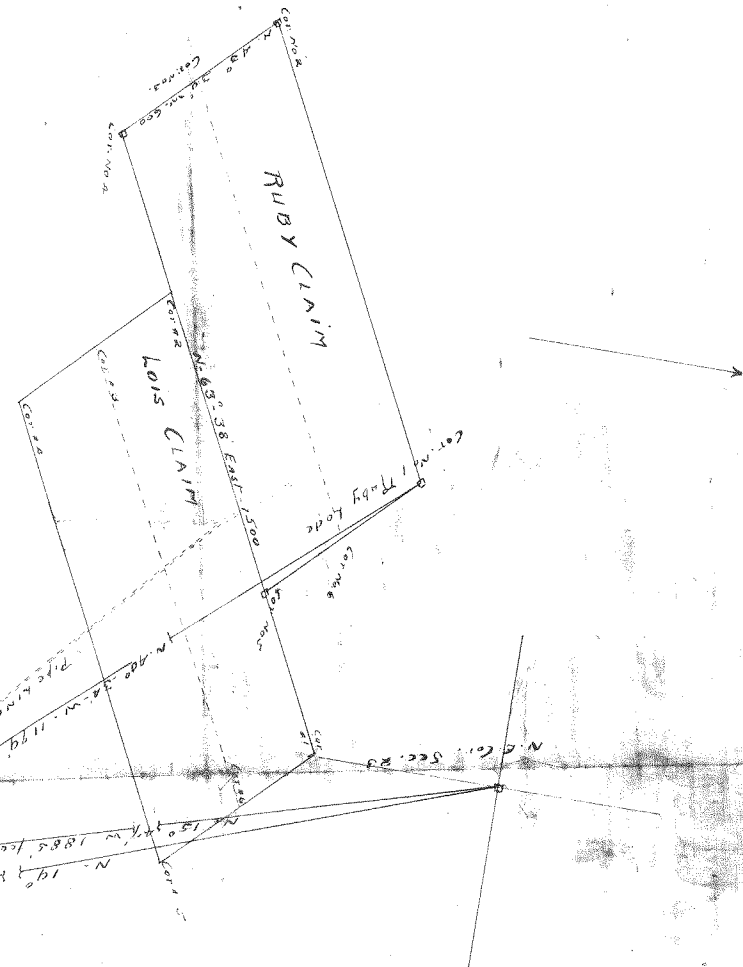

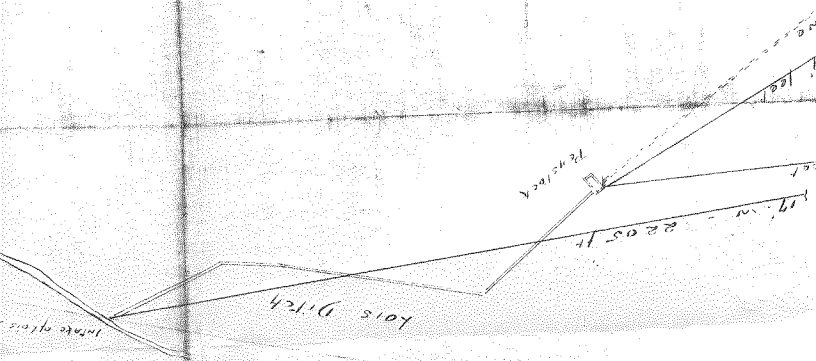

Jensen Ditch

Penslock


Penslock

Kois Ditch

$17.2 - 22.05 \text{ ft}$

$1:100$

JOY CREEK

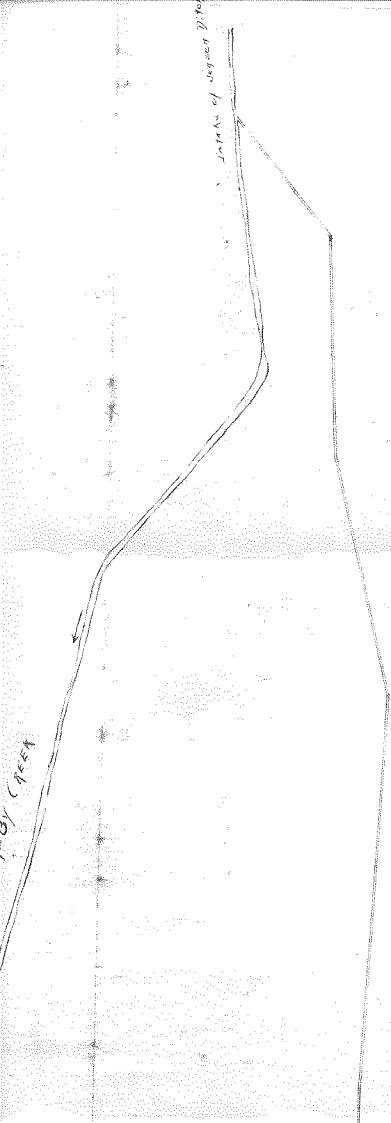

PLAN of LOIS DITCH LINE

SHOWING RELATION TO DIXIE MEADOWS MINING

Scale - 1" = 60'-0"

Scale of CLAIMS - 1" = 300'-0"

603-

77

CERTIFICATE OF SURVEYOR.

I, *Thomas L. Borman*, of *Waker Oregon*, do hereby certify that this map was made from notes taken during an actual survey made by me on *July 12th*, 1911, and that it correctly represents the works described in the accompanying application, together with the location of streams and other ditches in the immediate vicinity.

Thomas L. Borman

SURVEYOR.

FOOT TRAIL CREEK

