


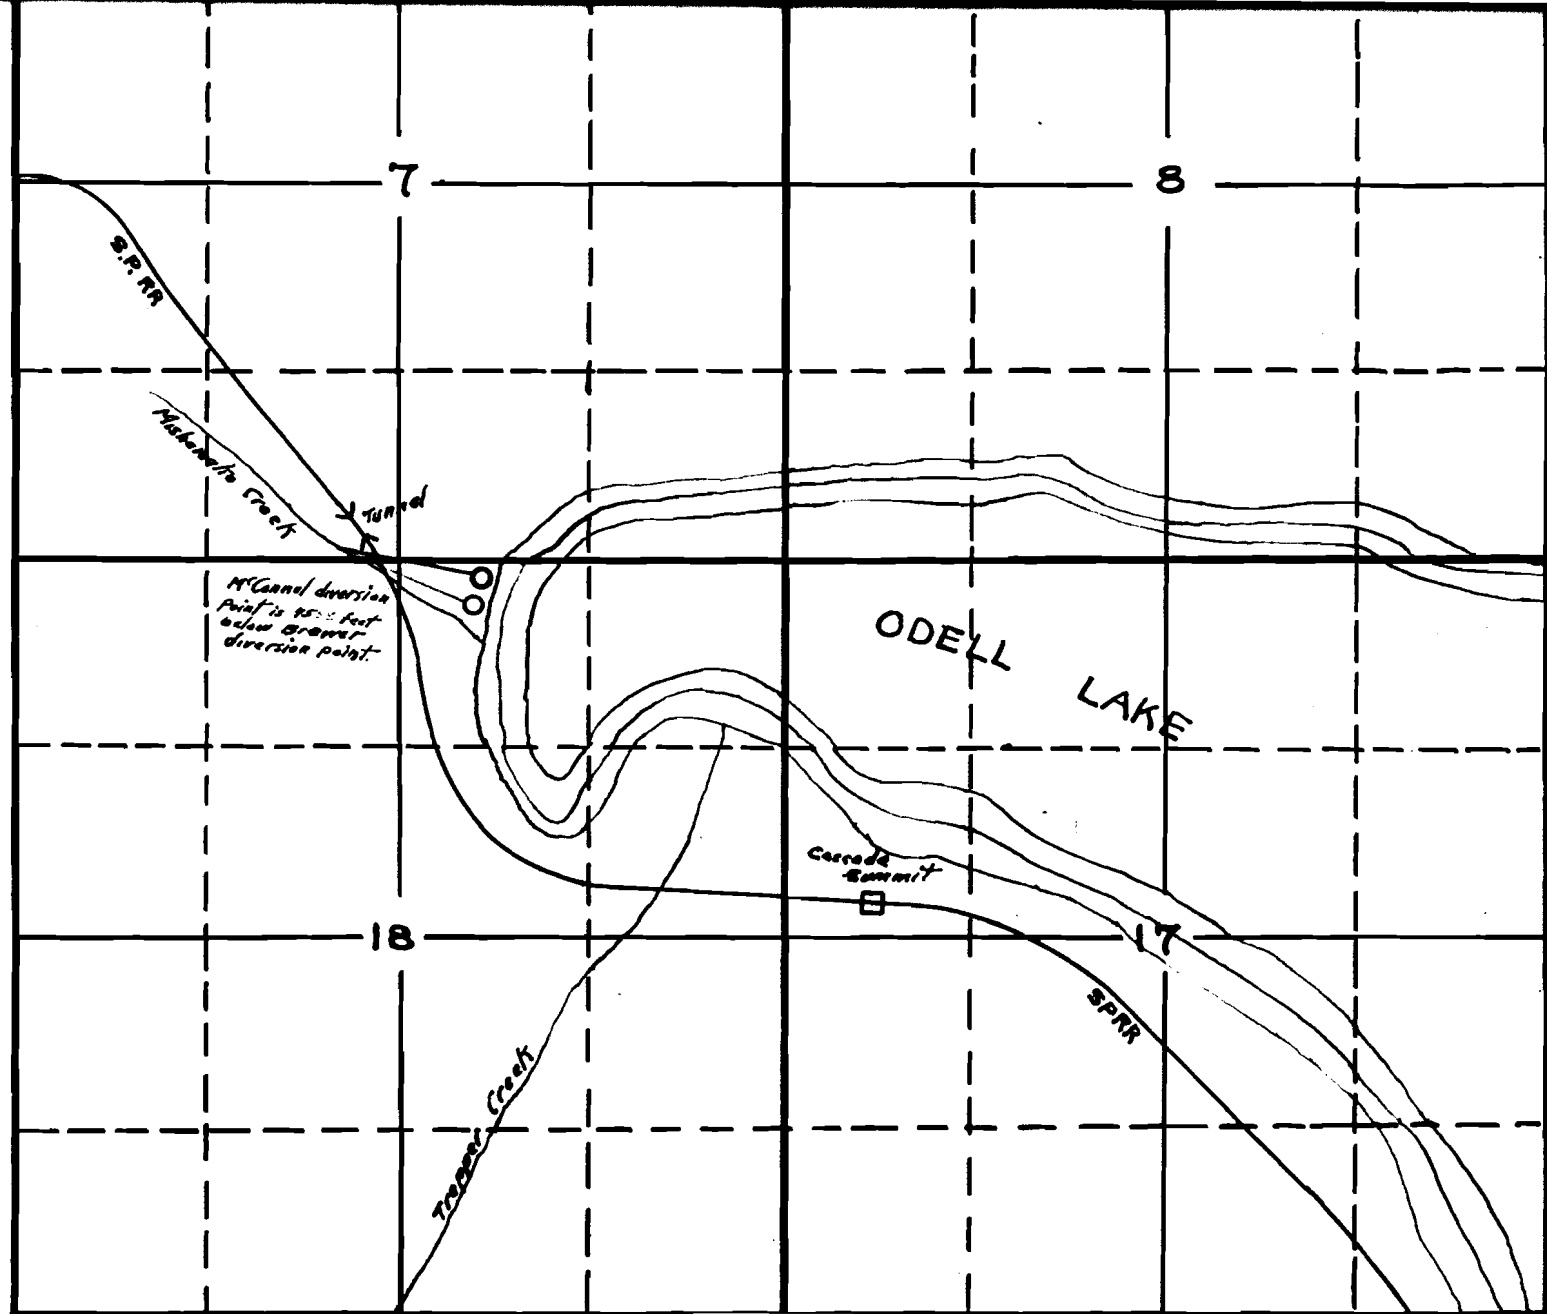

○ Brewer Residence ——— Brewer Pipeline
 ○ McConnel " ——— McConnel " "

Application No. 13749
 Permit No. 9886