


[illegible]

North

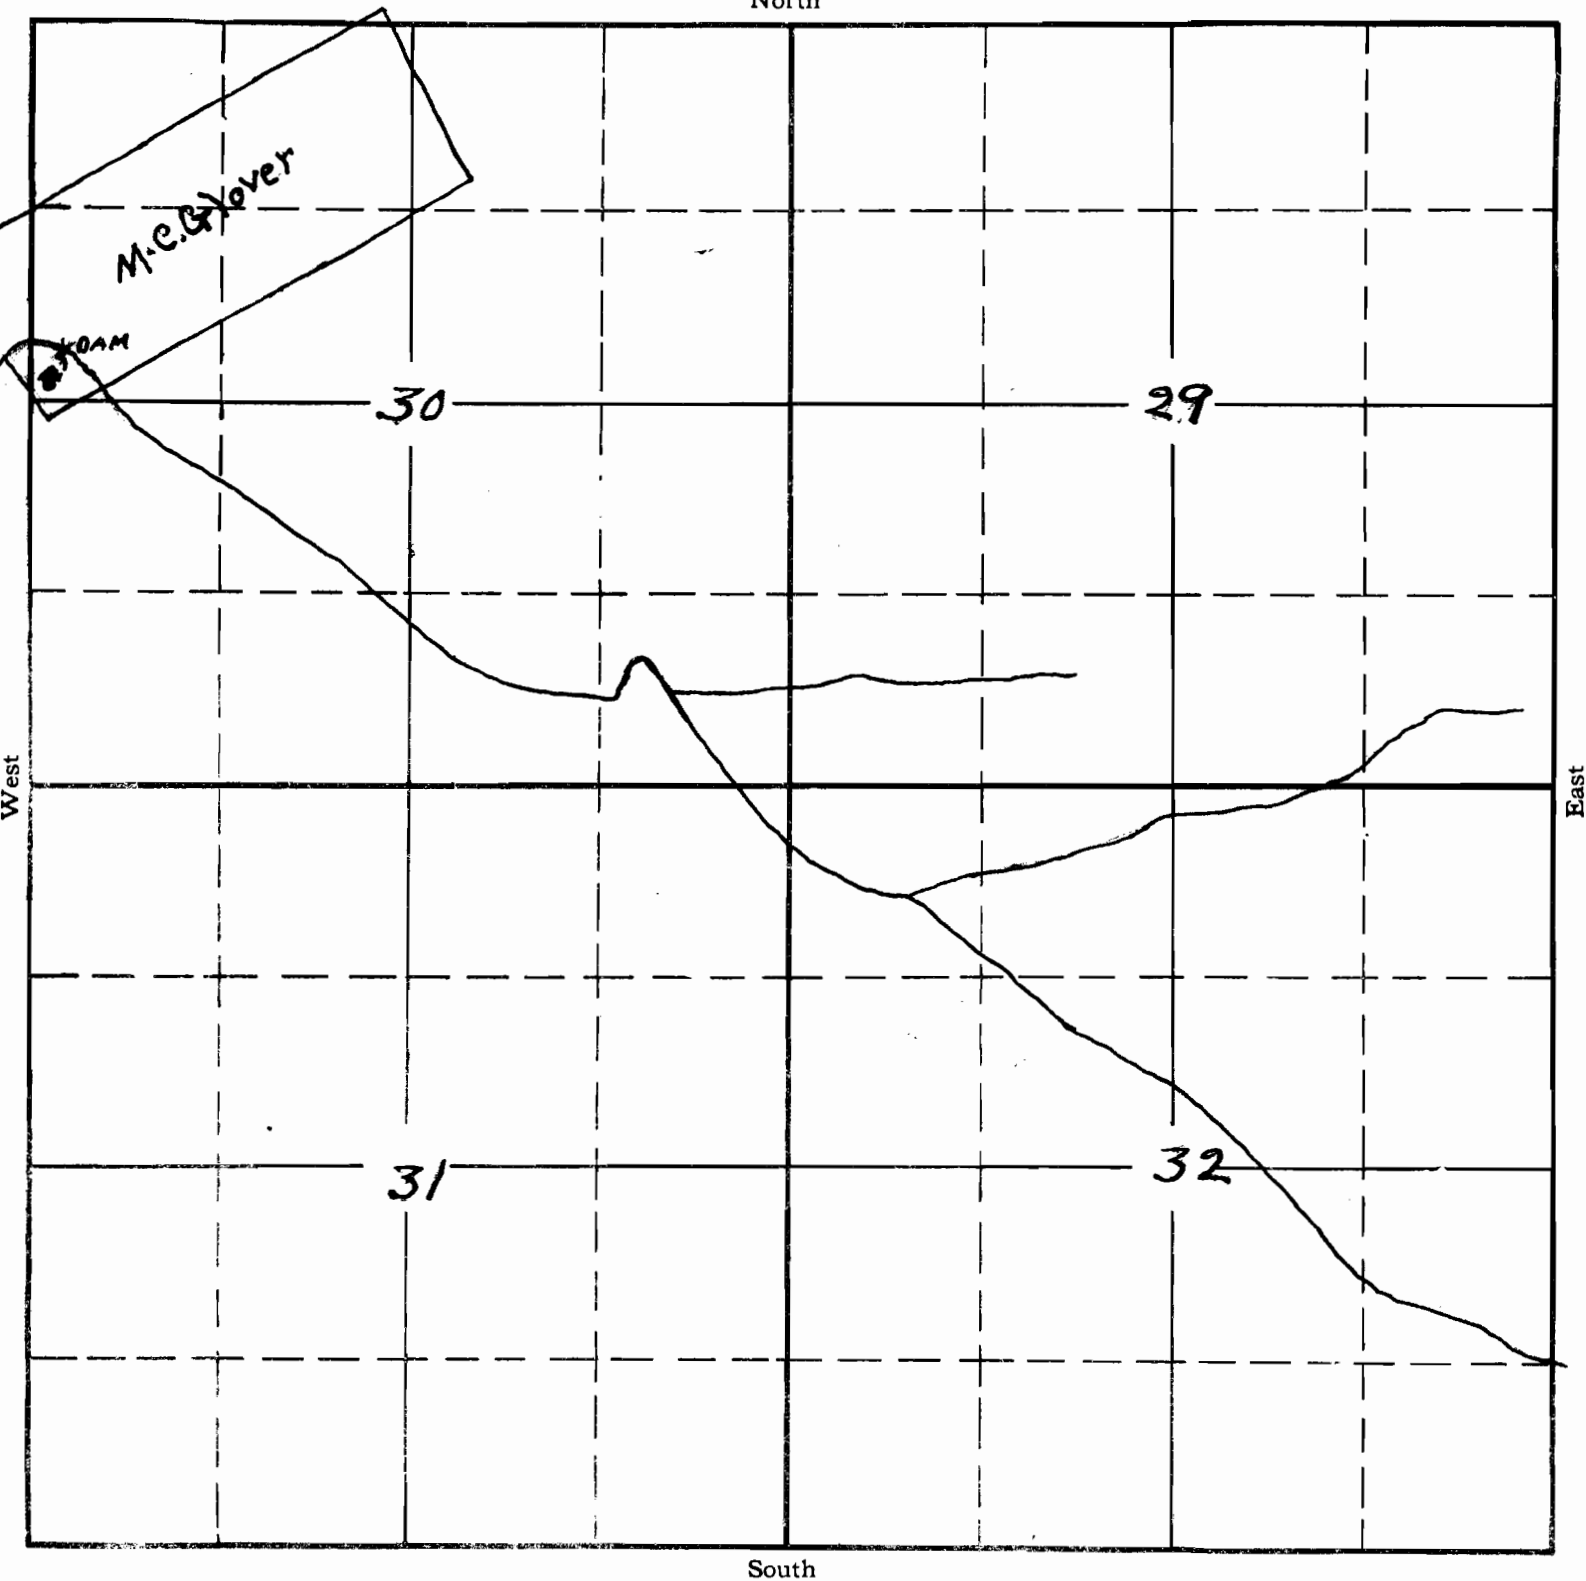

PERMIT No. 10292