


TOWNSHIP 8 S, RANGE 2 W, W. M.

North

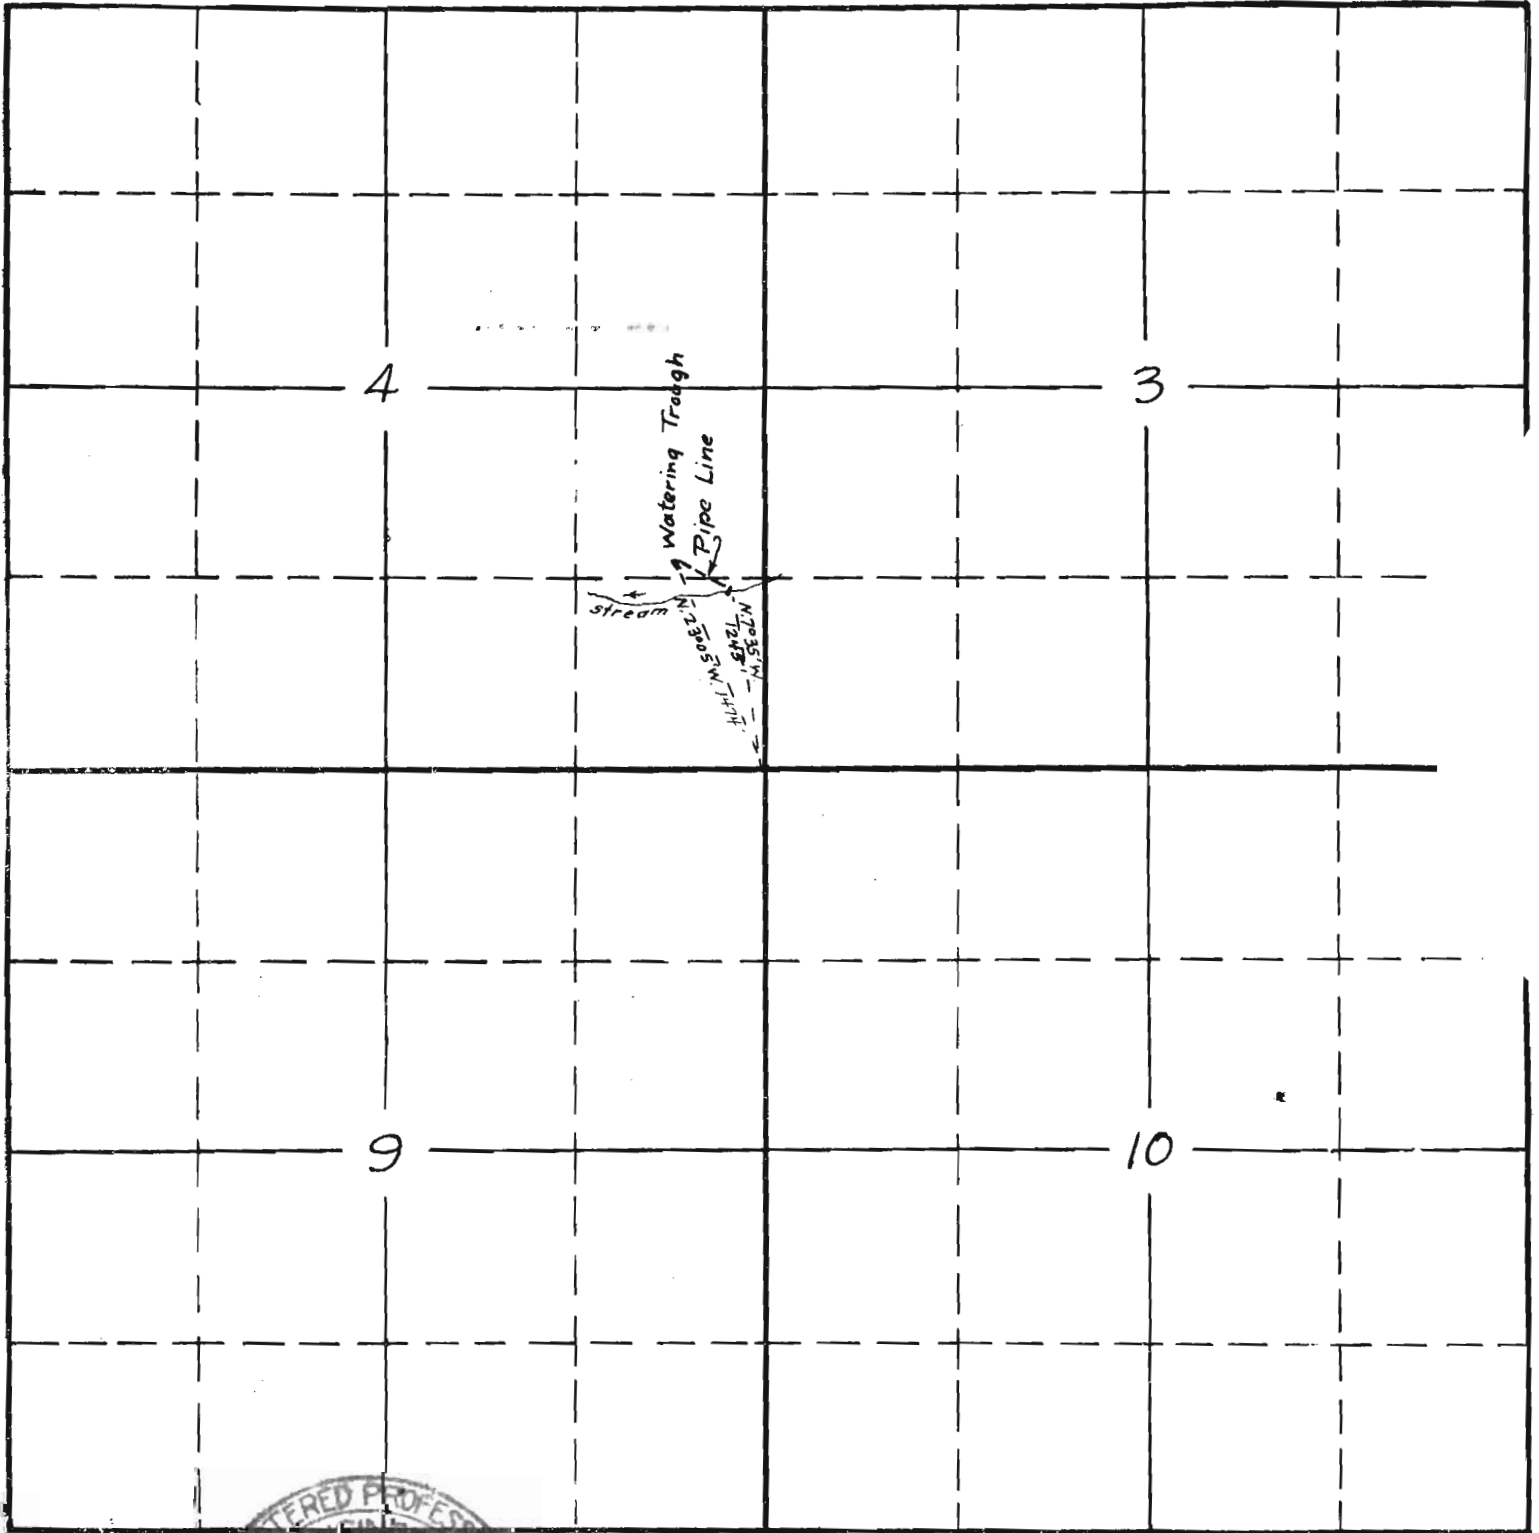

South



APPLICATION No. 14400
PERMIT No. 10427