

SECTION

12


TOWNSHIP 23S, RANGE 6½E, W. M.

North

West

East

12

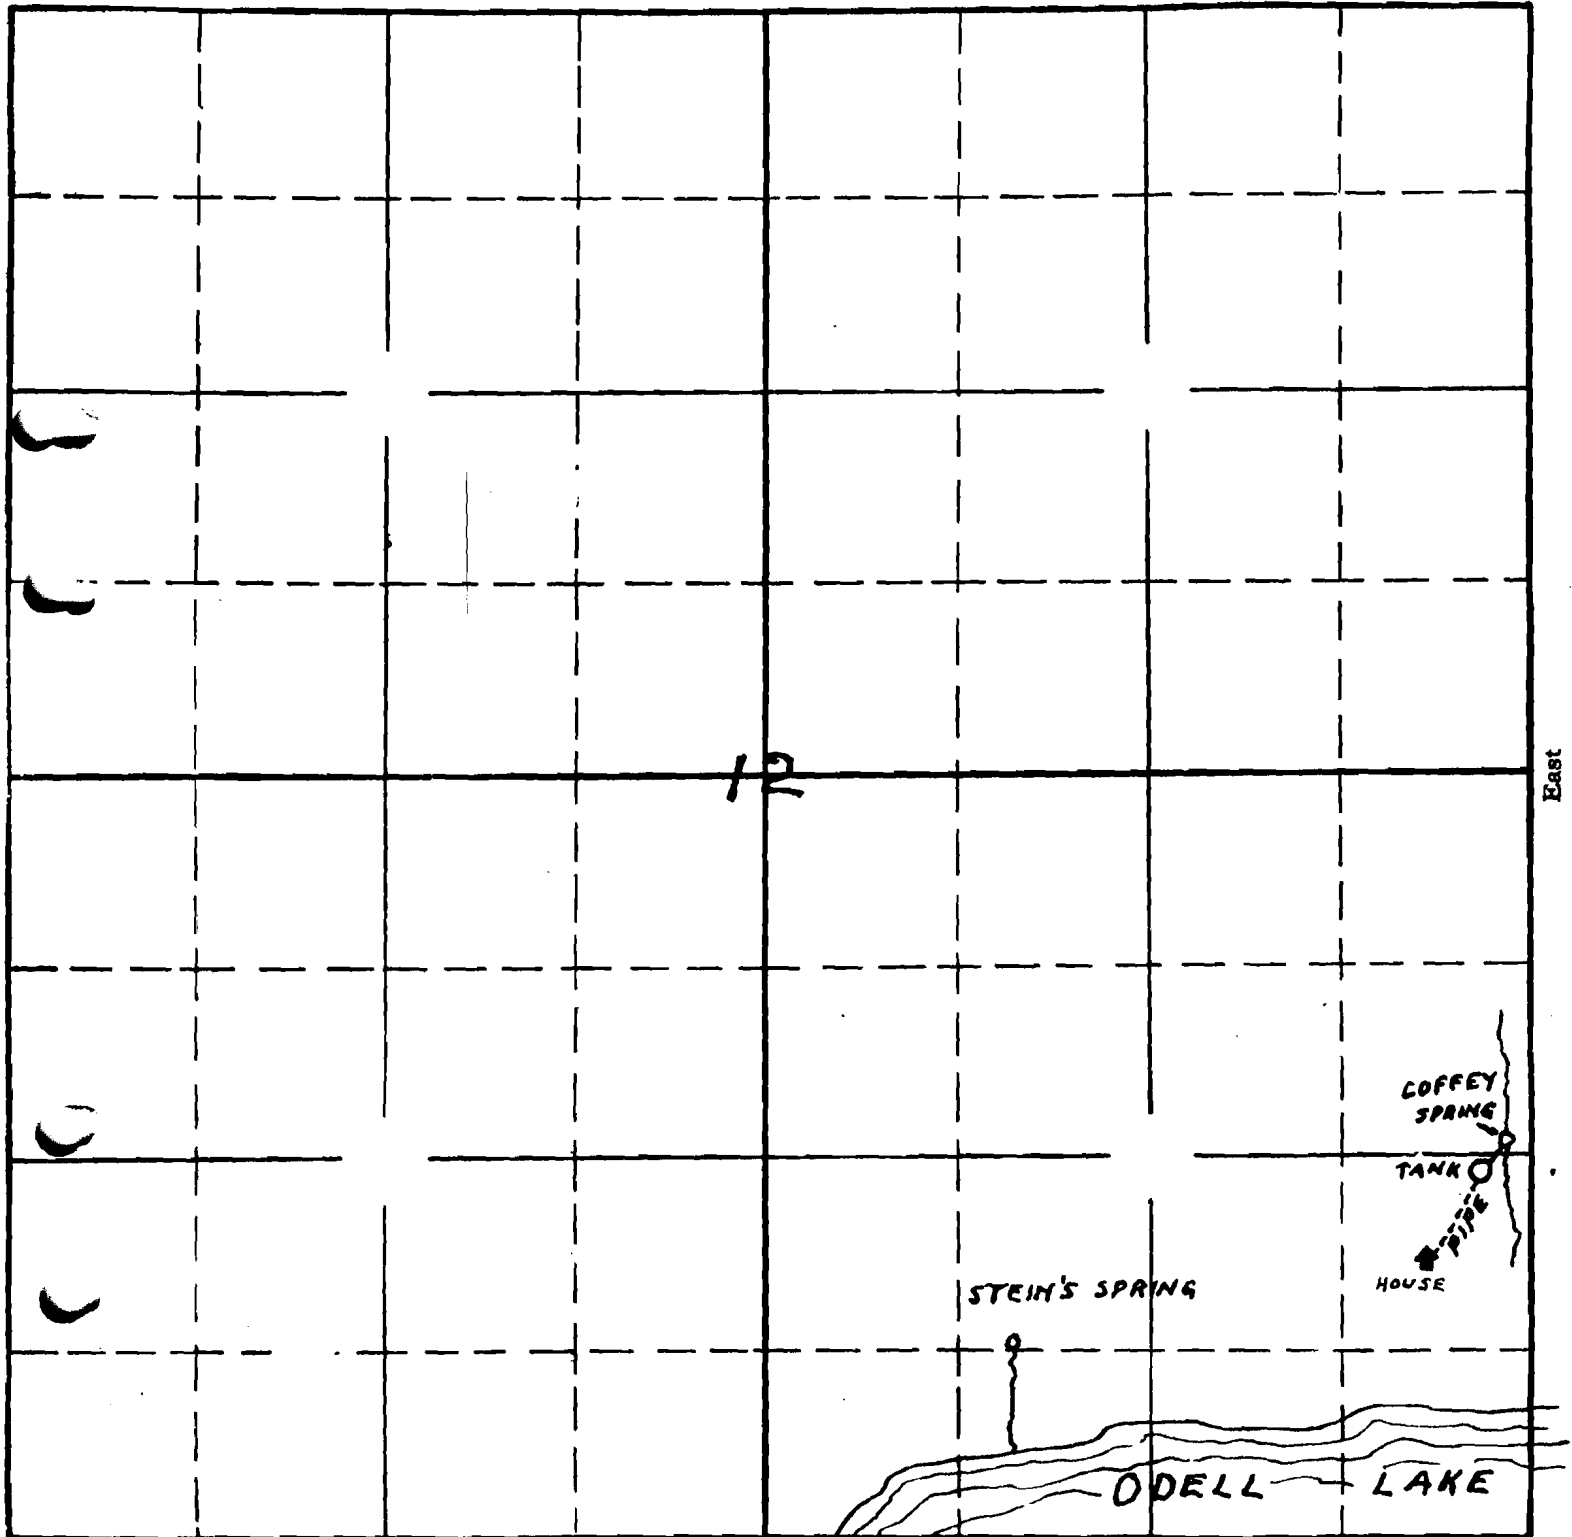

South

Drawn in State Engineer's Office
from applicant's sketch -
1/9/32 - B.

APPLICATION No. 74332

PERMIT No. 10453

C-10576

10453