

MILL CREEK IRRIGATION and POWER

BENTON COUNTY, OREGON.


STATE ENGINEER
RECEIVED

OCT 22 1924

SALEM, OREGON

Secs 35 & 2 Tps. 13 and 14S. R. 8W.

Scale: 1" = 40 chs.

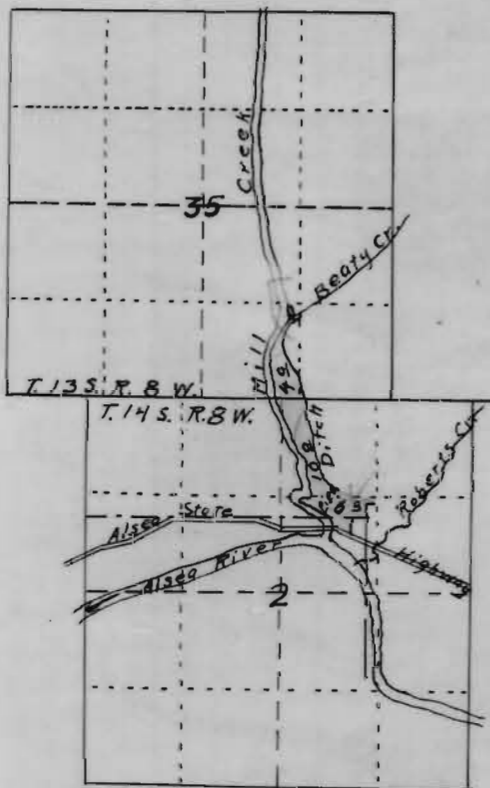

Traverse of Ditch Line

Beginning at a stone 2'x2'x2' which is 1272 feet North and 98 feet East of the 1/4 section corner on the north line of section 2 T. 14S. R. 8W. W.M. in Benton County, Oregon; thence (Needle bearings)

From sta. 0 to 1	S. 3° 35' E.	214 feet.
1 " 2	S. 38° 10' W.	153 "
2 " 3	S. 3° 30' E.	56 "
4	S. 16° 45' E.	170 "
5	S. 40° 35' E.	122 "
6	S. 44° 20' E.	182 "
7	S. 11° 25' E.	220 "
8	S. 14° E.	63 "


From sta. 8 1/4 sec. cor bears	S. 64° 10' W.	370 ft.
9	S. 6° 35' E.	261 feet.
10	S. 23° 50' E.	209 "
11	S. 13° E.	151 "
12	S. 23° E.	103 "
13	S. 27° E.	153 "
14	S. 17° 50' E.	194 "
15	S. 19° 50' E.	223 "
16	S. 53° 10' E.	150 "

to the end of ditch and beginning of pipe line, which pipe line is S. 30° W. 500 feet to Mill Creek
From beginning point a Maple 34" bears N. 84° E. 57 feet
Elev. of beginning point 413.45 feet.
Elev. of end of ditch 396.85 "
Elev. of end of pipe line 346.85 "

Certificate of Surveyor

I, W. C. Galloway of Corvallis, Oregon, certify that this map was made from notes taken during an actual survey made by me on Sept. 26, 1924, and that it correctly represents the marks described in the accompanying application together with the location of streams and other ditches in the immediate vicinity, and has written thereon the area in each smallest legal subdivision which it is to irrigate

W. C. Galloway
County Engineer
Registered Engineer No. 44

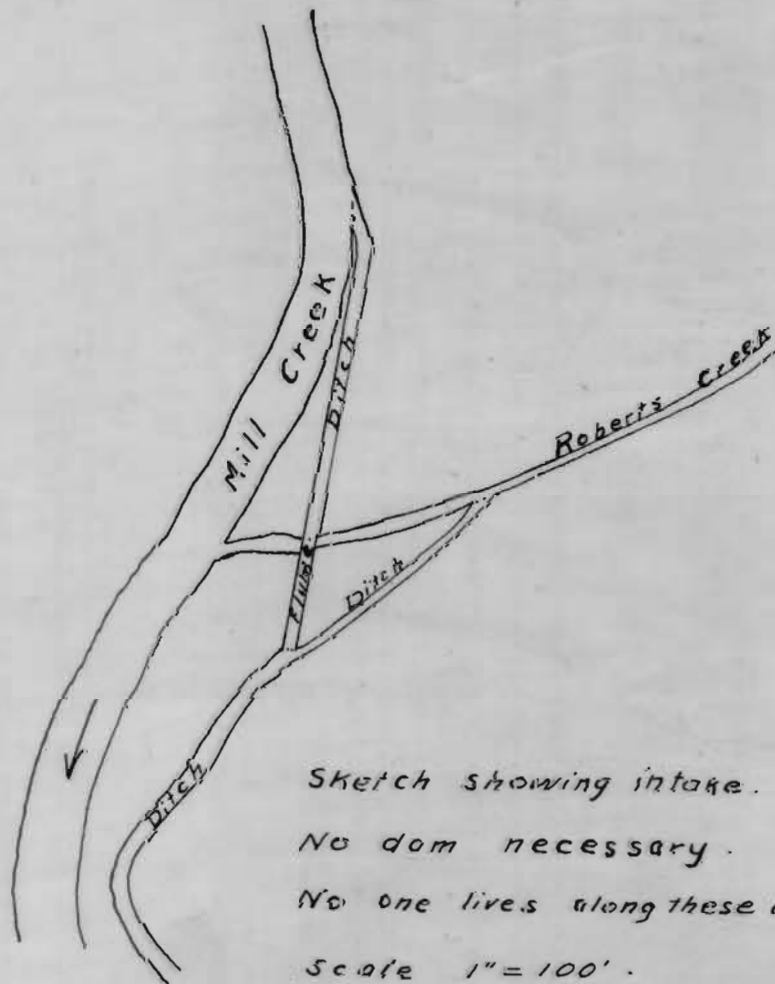

Sketch showing intake.
No dam necessary.
No one lives along these creeks.
Scale 1" = 100'.

Application No. 9895
Permit No. 6557

