


STATE ENGINEER
RECEIVED

MAR 1 1924

SALEM, OREGON

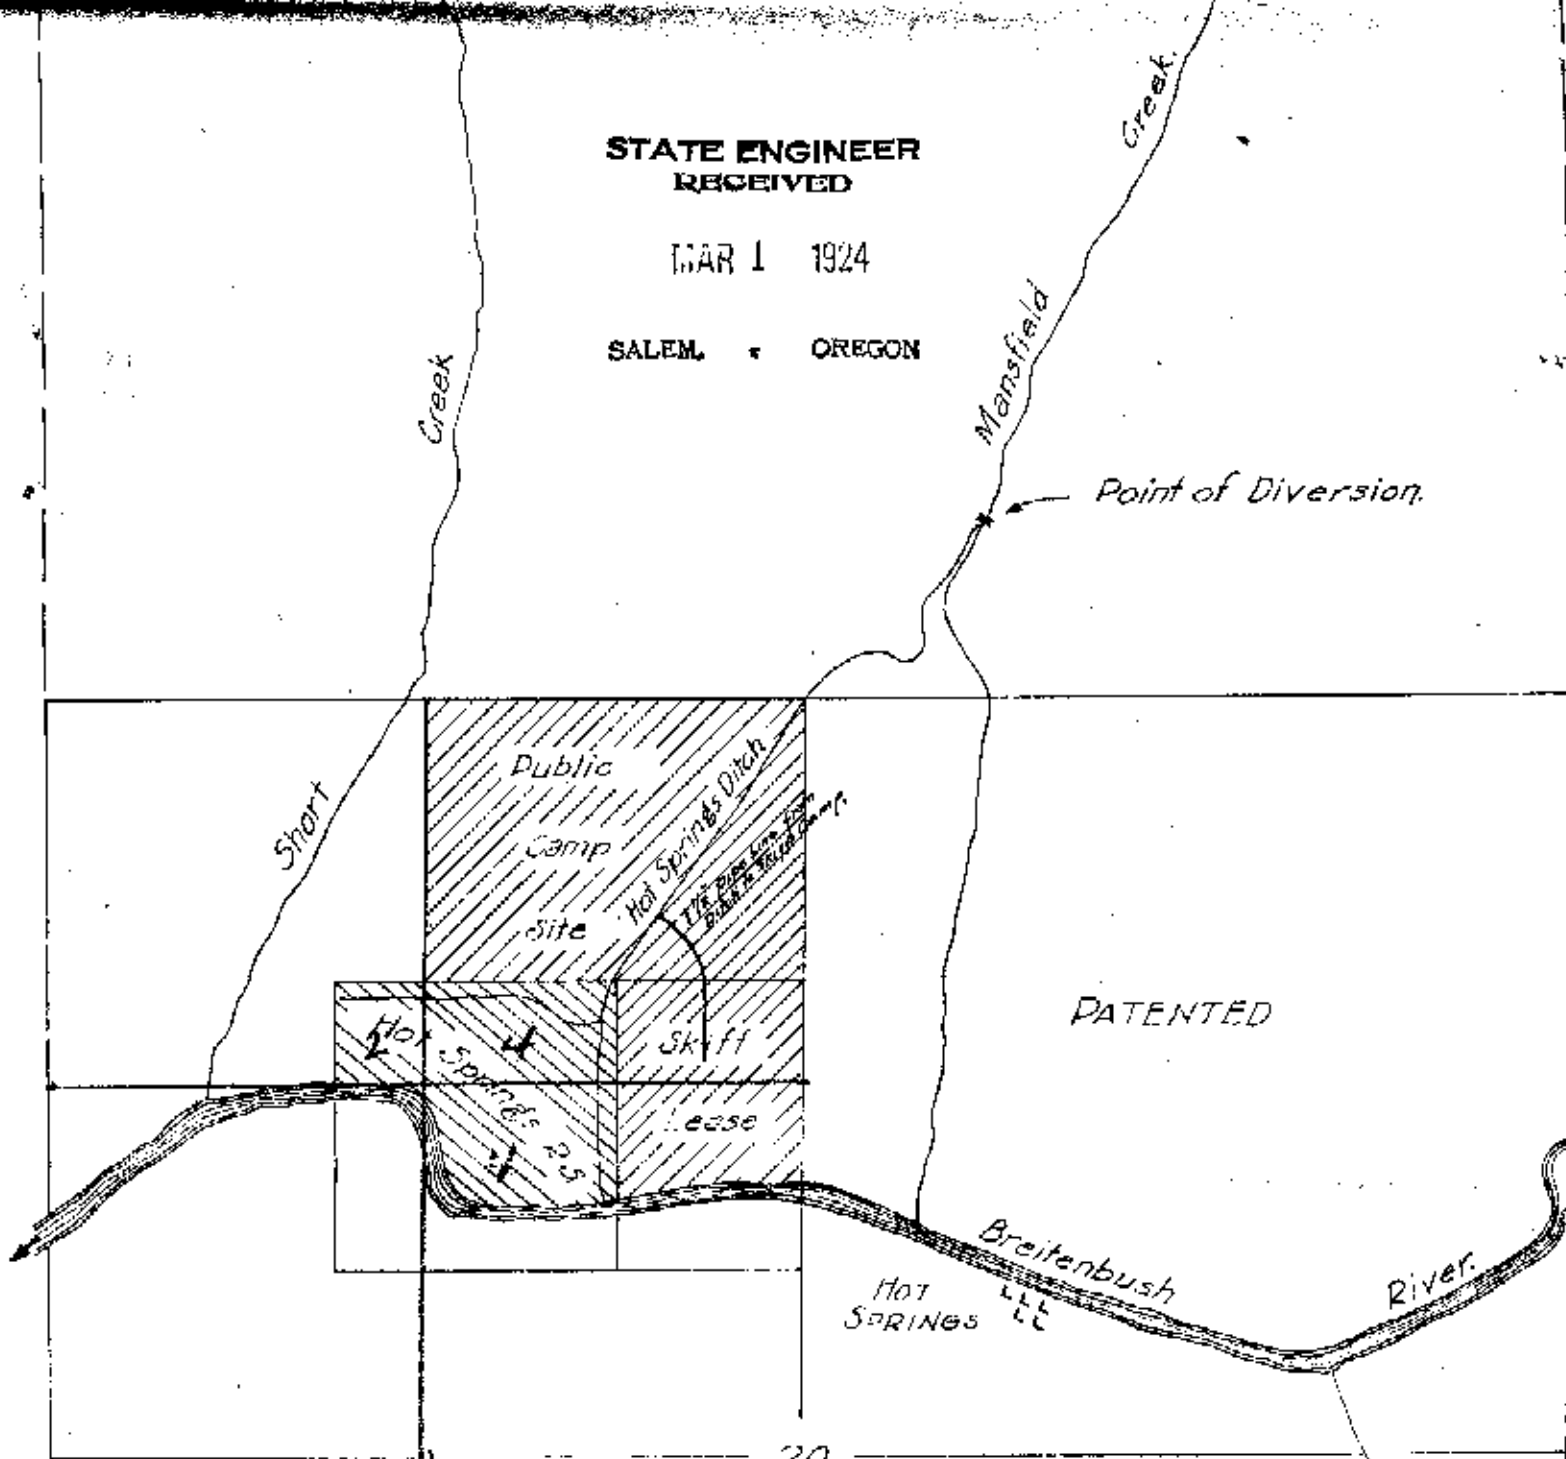

MAP OF WATER DIVERSION
MANSFIELD CREEK
SANTIAM NATIONAL FOREST
MARION COUNTY, OREGON

T. 9 S., R. 7 E., W. M.

SECTIONS 17 & 20

Acres 640.00

Overall Forest Supervisor


Marion County

2 acres in new - new
new
384
Acres 20

RECEIVED
MAR 1 1924

Application No. 9400
Permit No. 6242

Cent 10638

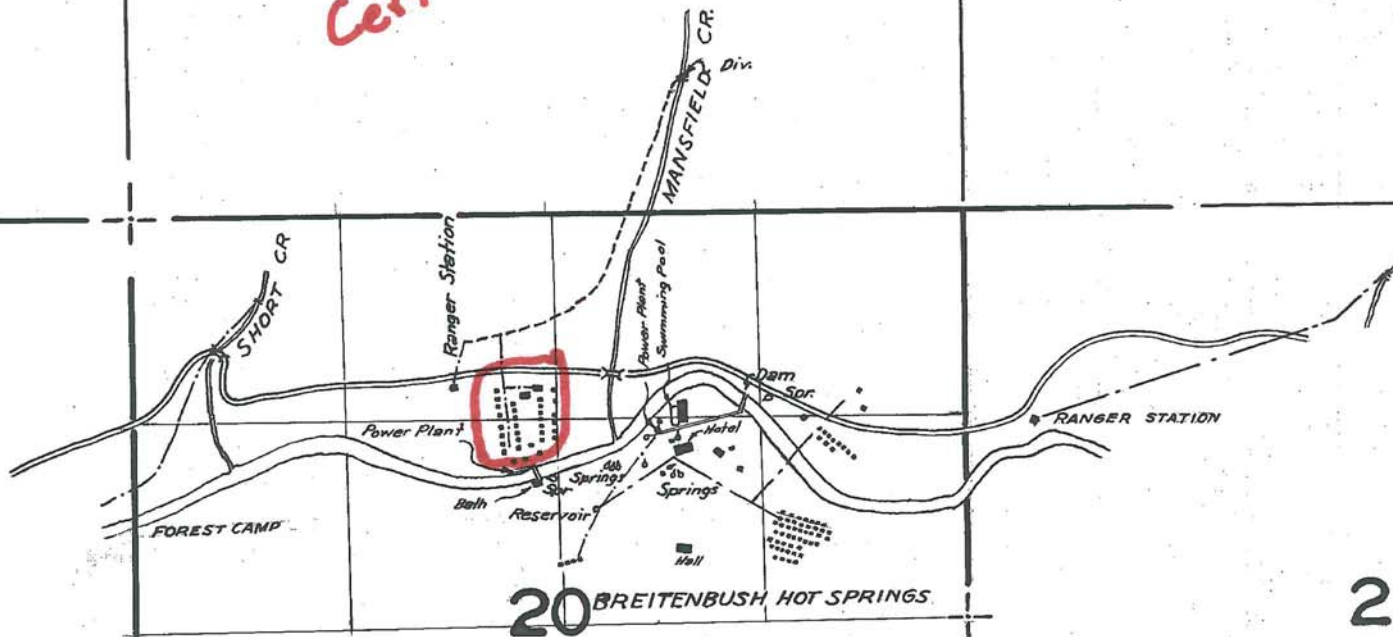

21