


11733

P. B. Wickham

Scale 2" = 1 Mile

March 28, 1928

T. 34 S., R. 7 and 8 W., W.M.

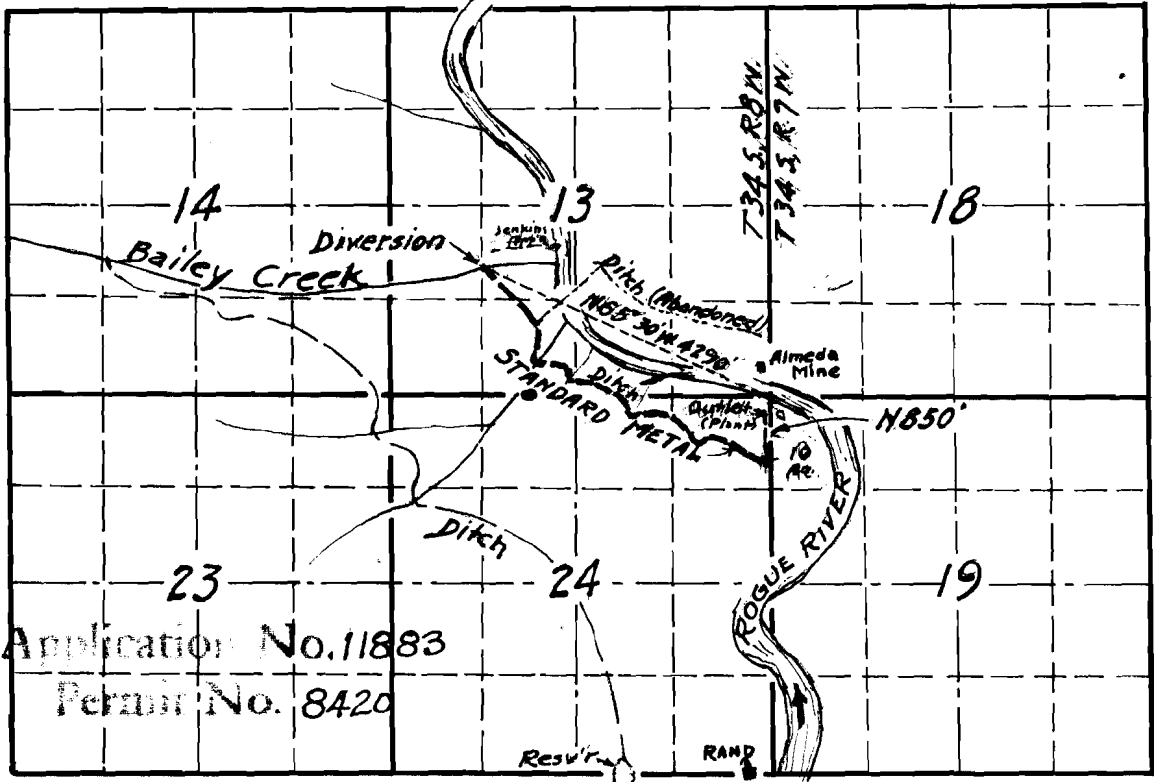

Application No. 11883
Permit No. 8420

I, Tom R. Pearce, of Grants Pass, Ore, do hereby certify that this map was made from notes taken by a survey that was made prior to Mar. 28, 1928. The southeast corner of (above) Sec. 13, was found and tied to point of diversion. The map correctly represents the works described in the accompanying application, together with the location of streams and other ditches in the immediate vicinity.

