


Per # 9376

10649

Section = 1 mile

Twp 10 SR 30 E

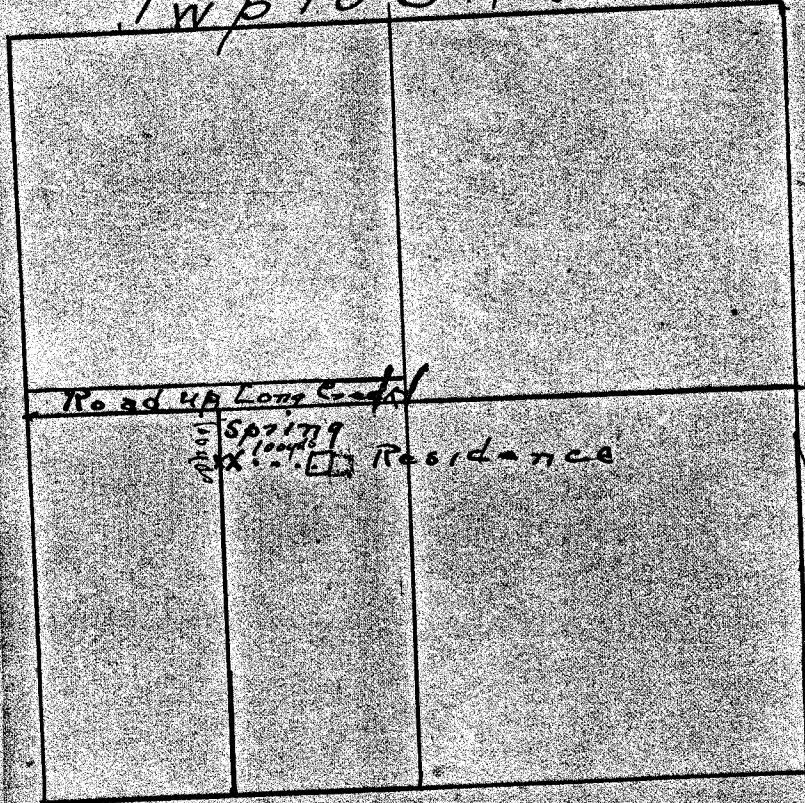

Application No. 10034  
Permit No. 9376