


T.15S.,R.1W.,W.M.

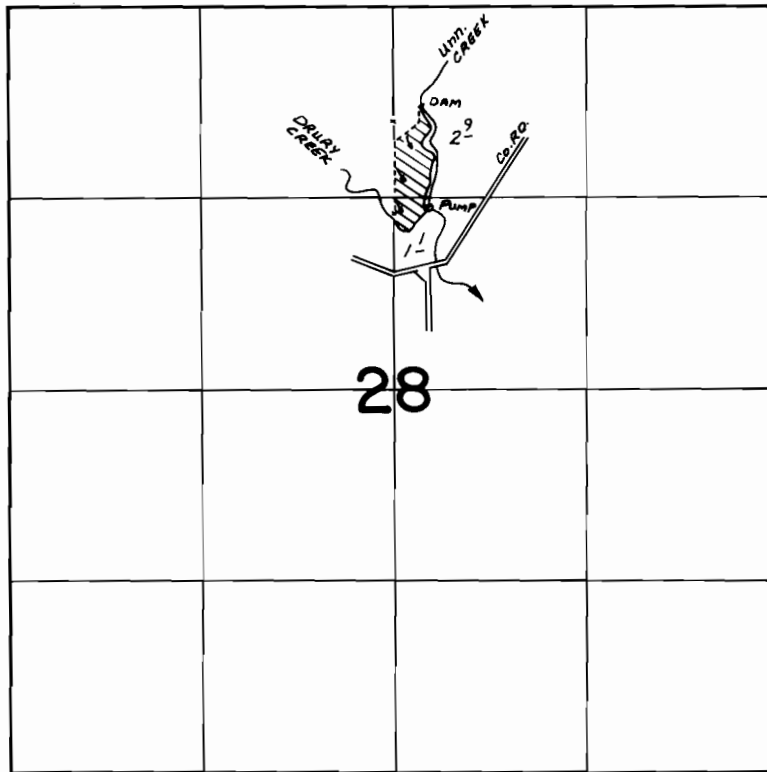

DIV LOC: DAM - 680 ft S and 200 ft E } BOTH FROM N 1/4 COR 36C 28  
PUMP - 1400 ft S and 230 ft E }

**FINAL PROOF SURVEY**  
UNDER

Application No. ..13441... Permit No. ..9652.....  
IN NAME OF

.....  
Surveyed July 14 1982, by L. M. TOLL.....