


SECTION

TOWNSHIP 18 S, RANGE 16 E, W. M.

North

West

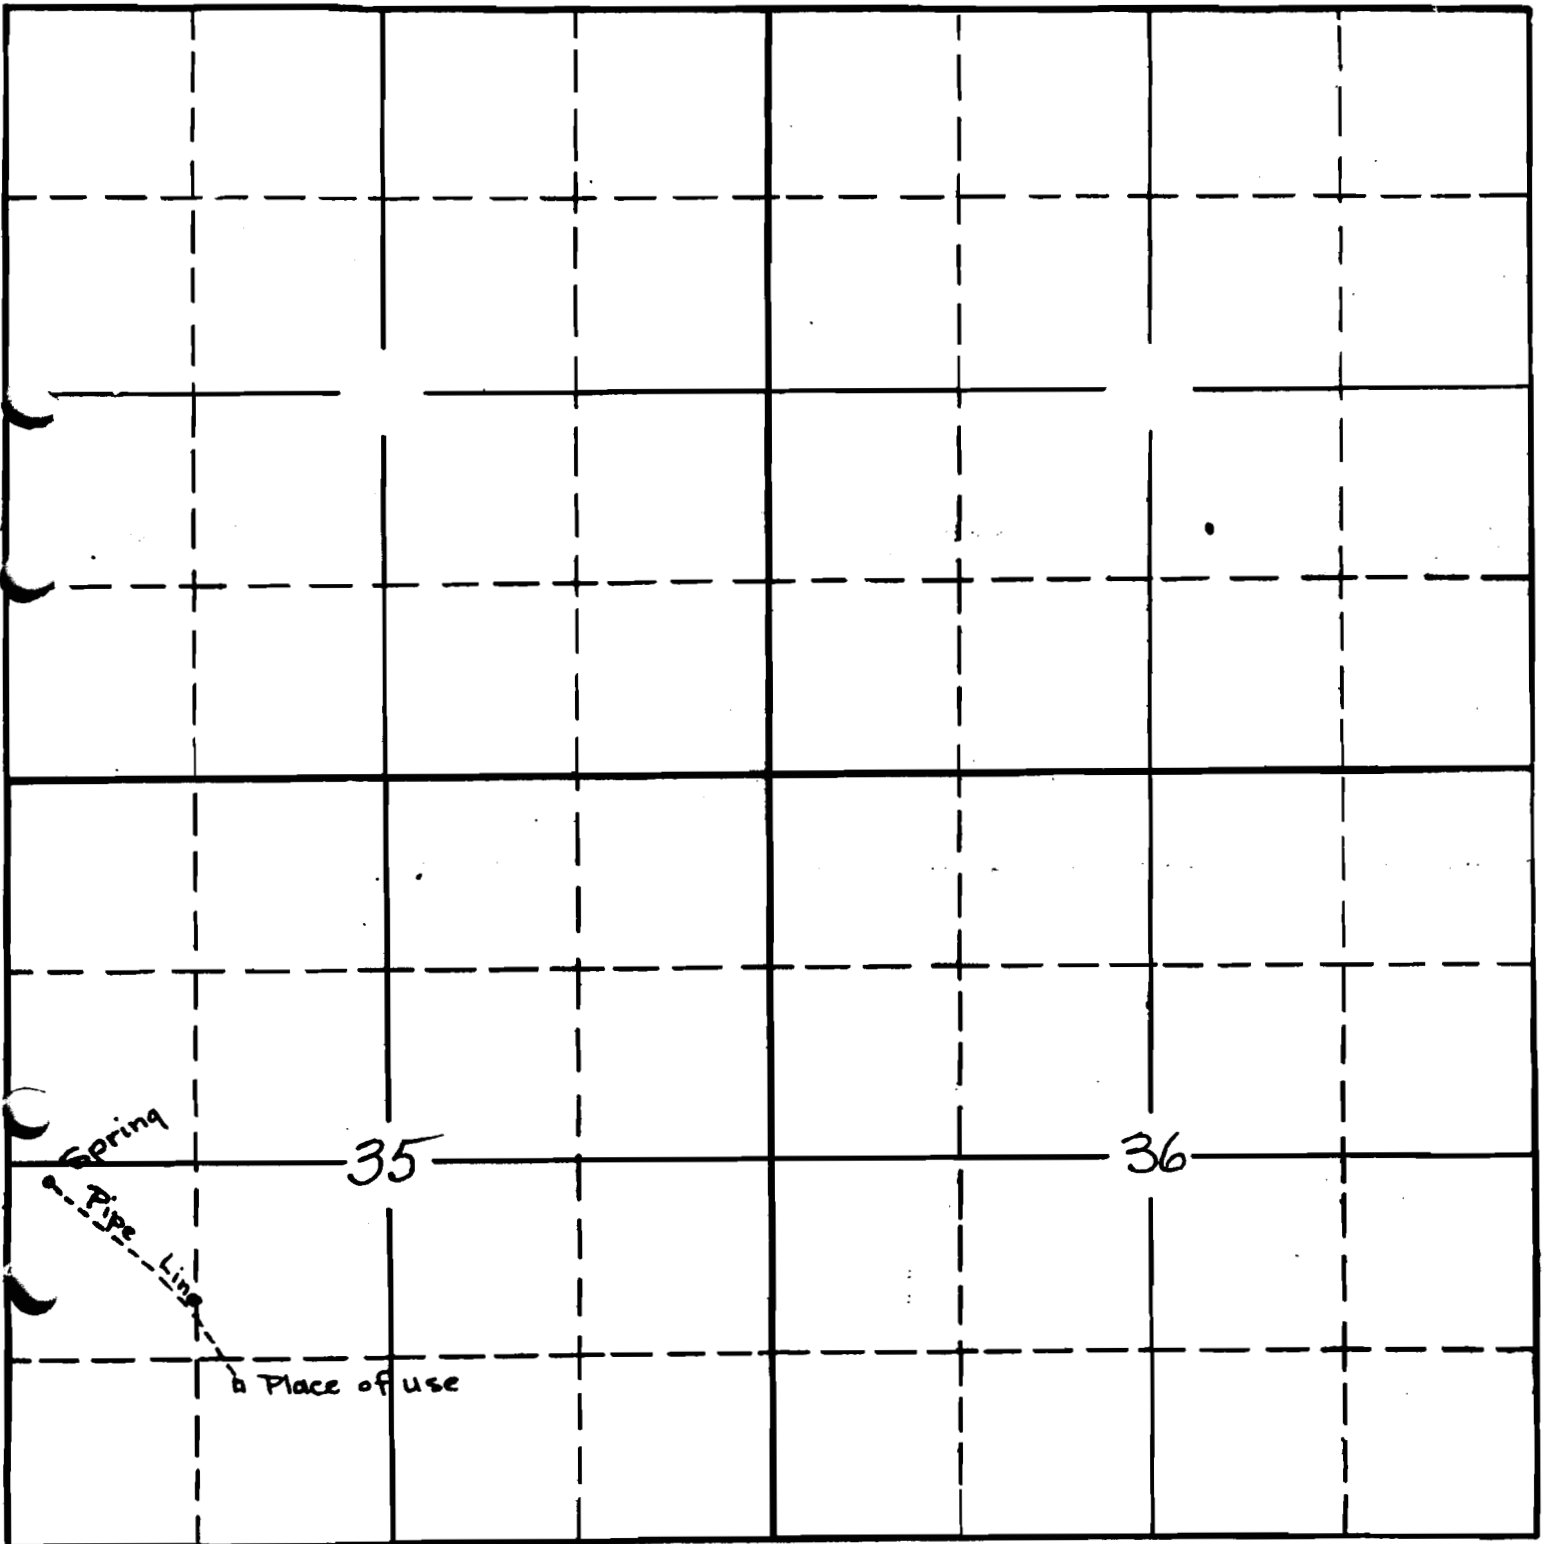

South

APPLICATION No. 13548

PERMIT No. 9801

C-106664

9801