


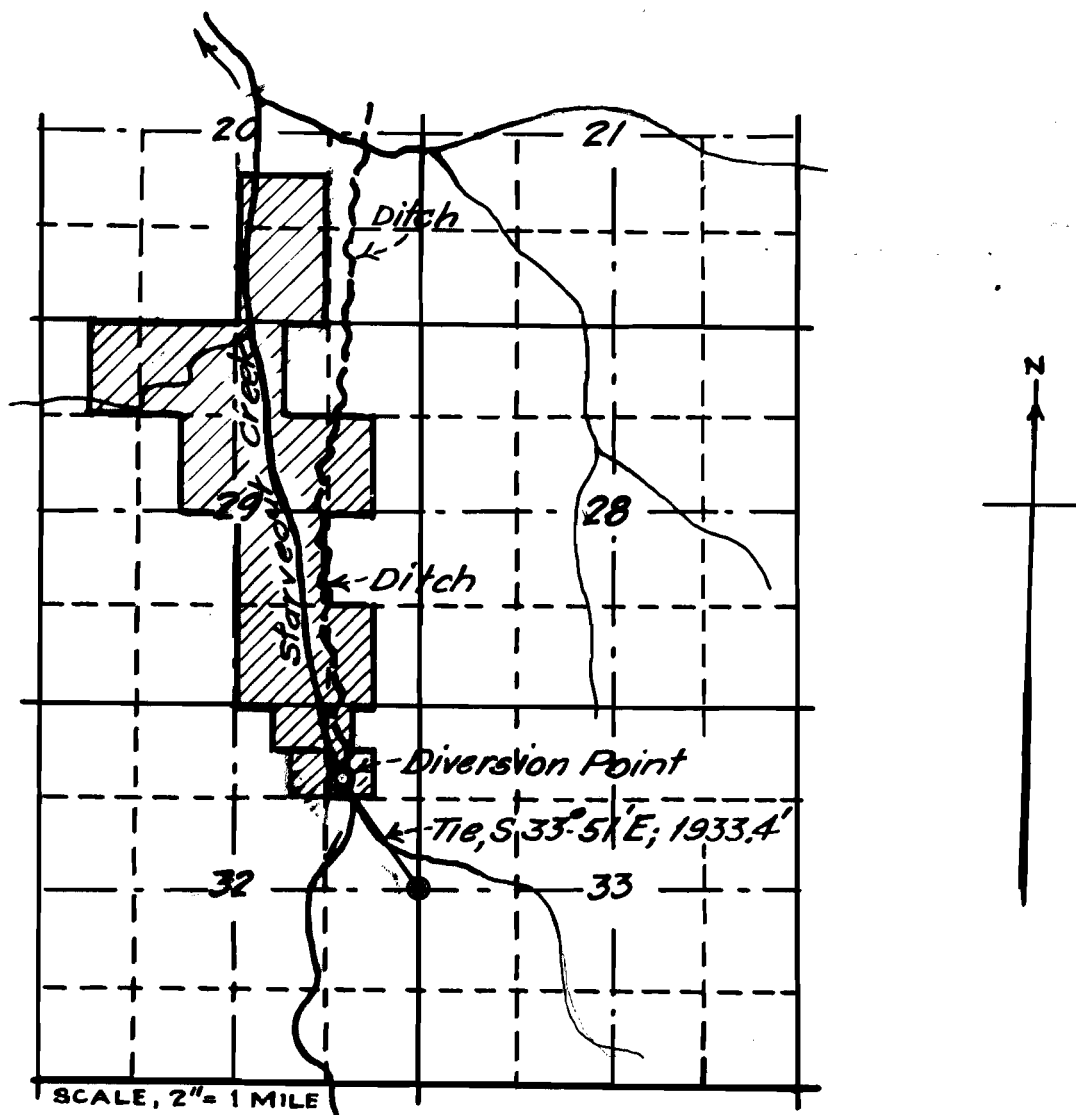

GREEN MOUNTAIN MINING WATER FILING BY JAMES C. GARIFIELD.

SEC'S. 20, 29 & 32, T32S; R.4W; W.M.

CERTIFICATE OF REGISTERED PROFESSIONAL ENG'R.

I, H.L. Eppstein, of Roseburg, Oregon, do hereby certify that this map was made from notes taken during an actual survey made by me on February 1st & 2nd, 1929, and that it correctly represents the works described in the accompanying application, together with the location of streams in the immediate vicinity.

Oregon No. 1011

Date of Registration, Nov. 8, 1920.

Harvey L. Eppstein
Registered Professional Engineer.

Application No 14861
Permit No 10824