


TOWNSHIP 23 S., RANGE 6 E., W. M.

North

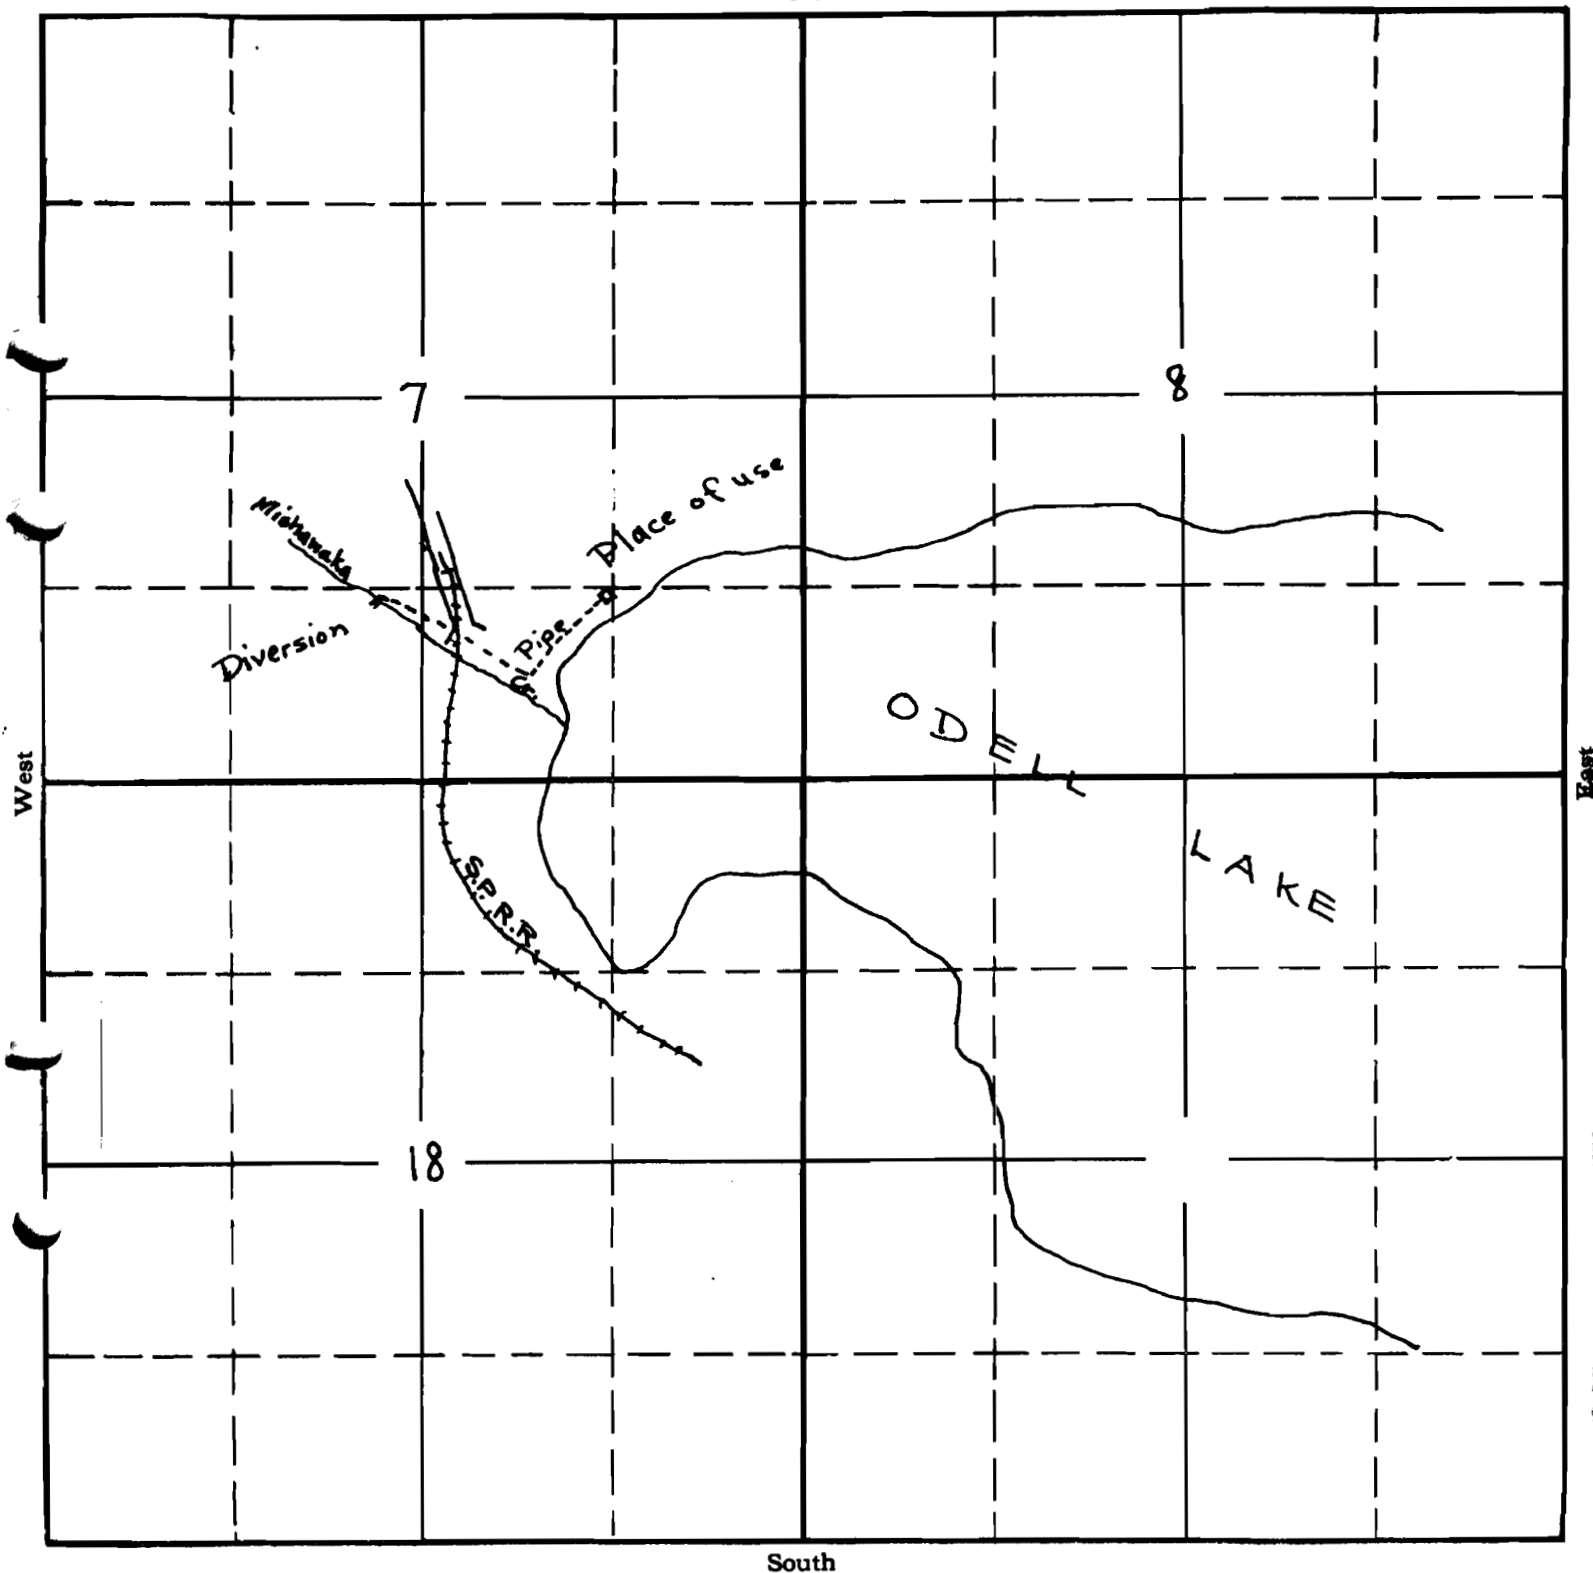

South

APPLICATION No. 15110
PERMIT No. 11024

11024