


Sec. _____

Tp. 10 S

R. 26 E

P 8358

10708

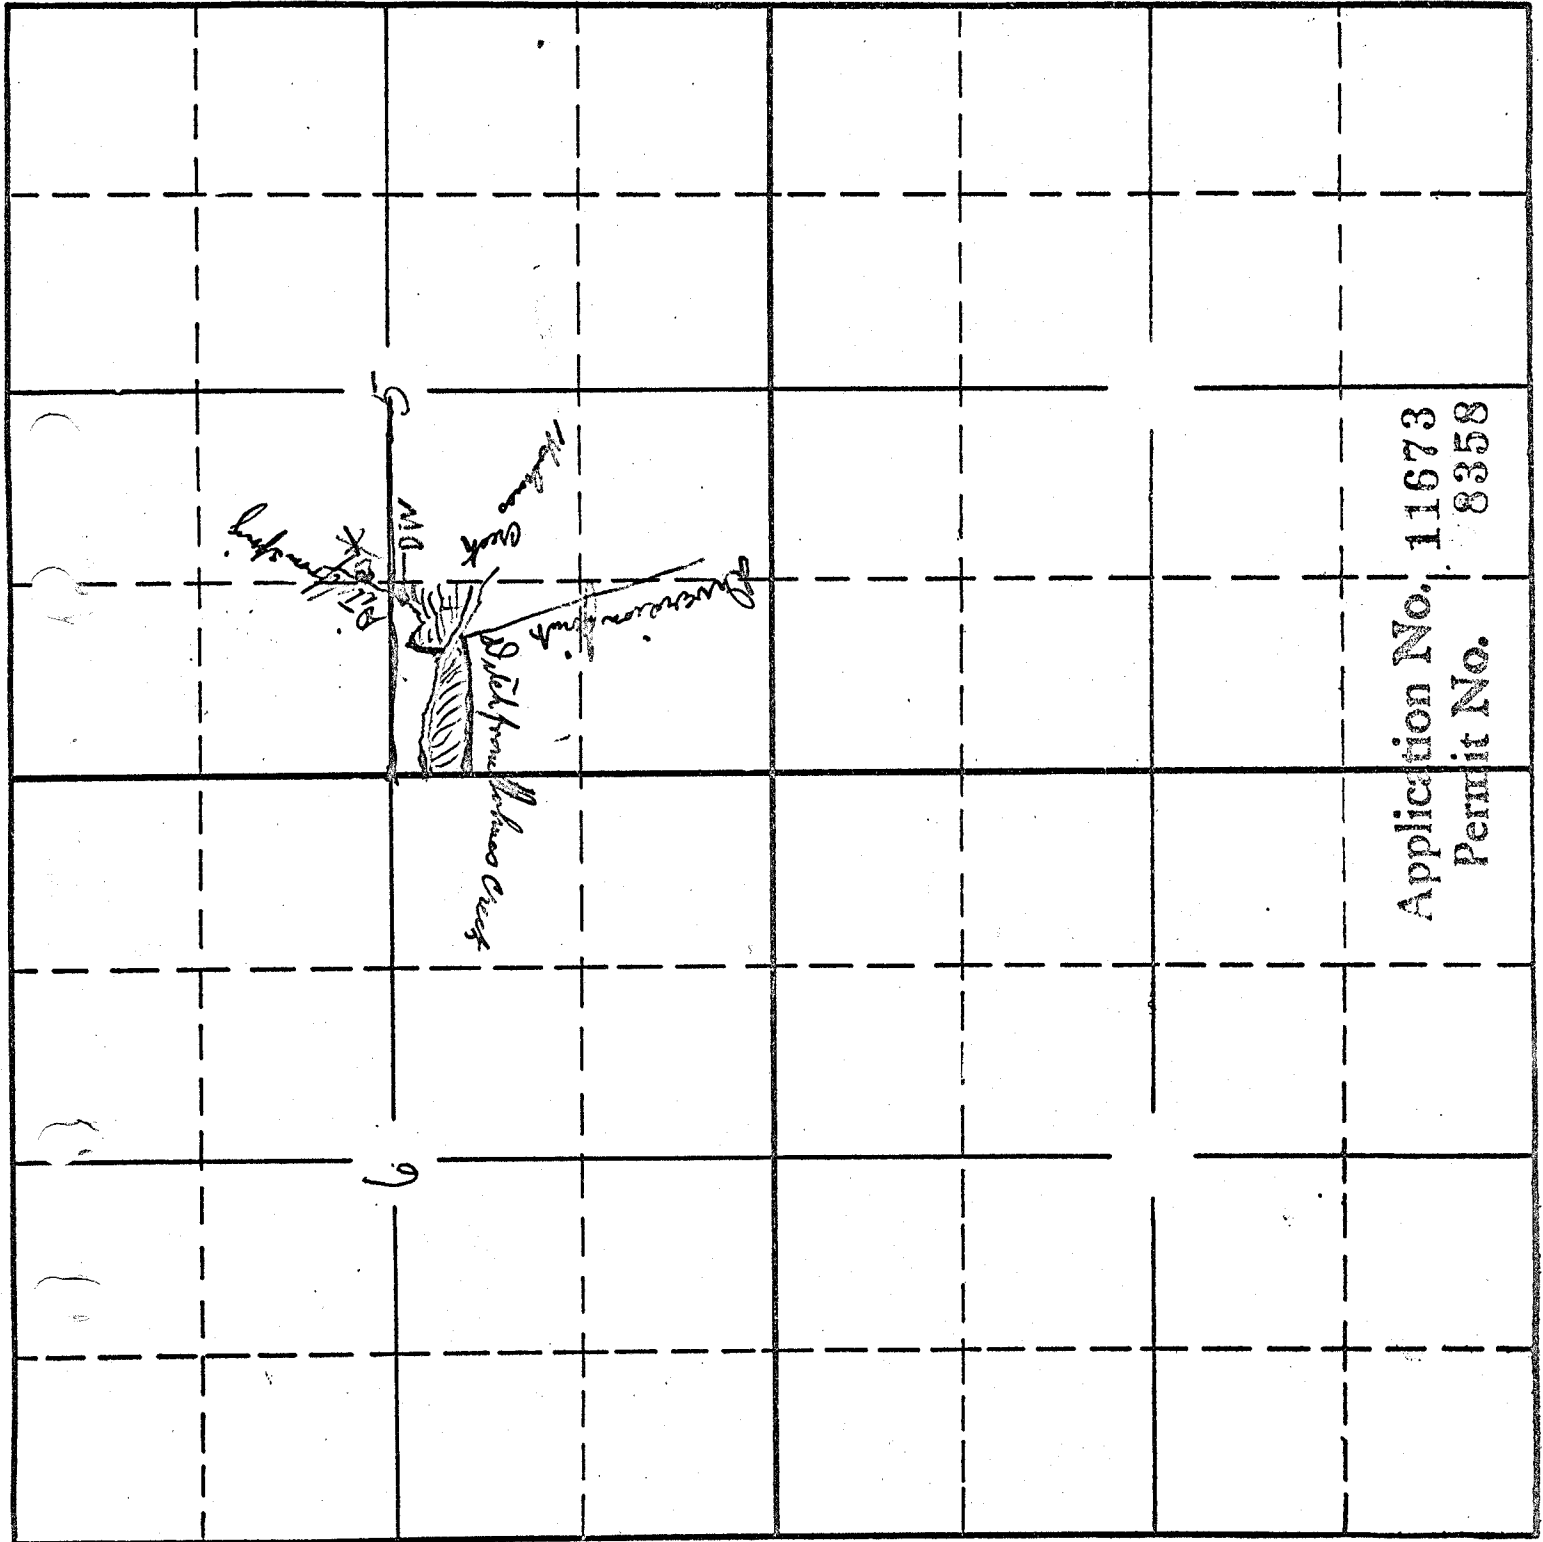

Application No. 11673
Permit No. 8358