


Mapped by _____ Scale: **2** inches = 1 mile.

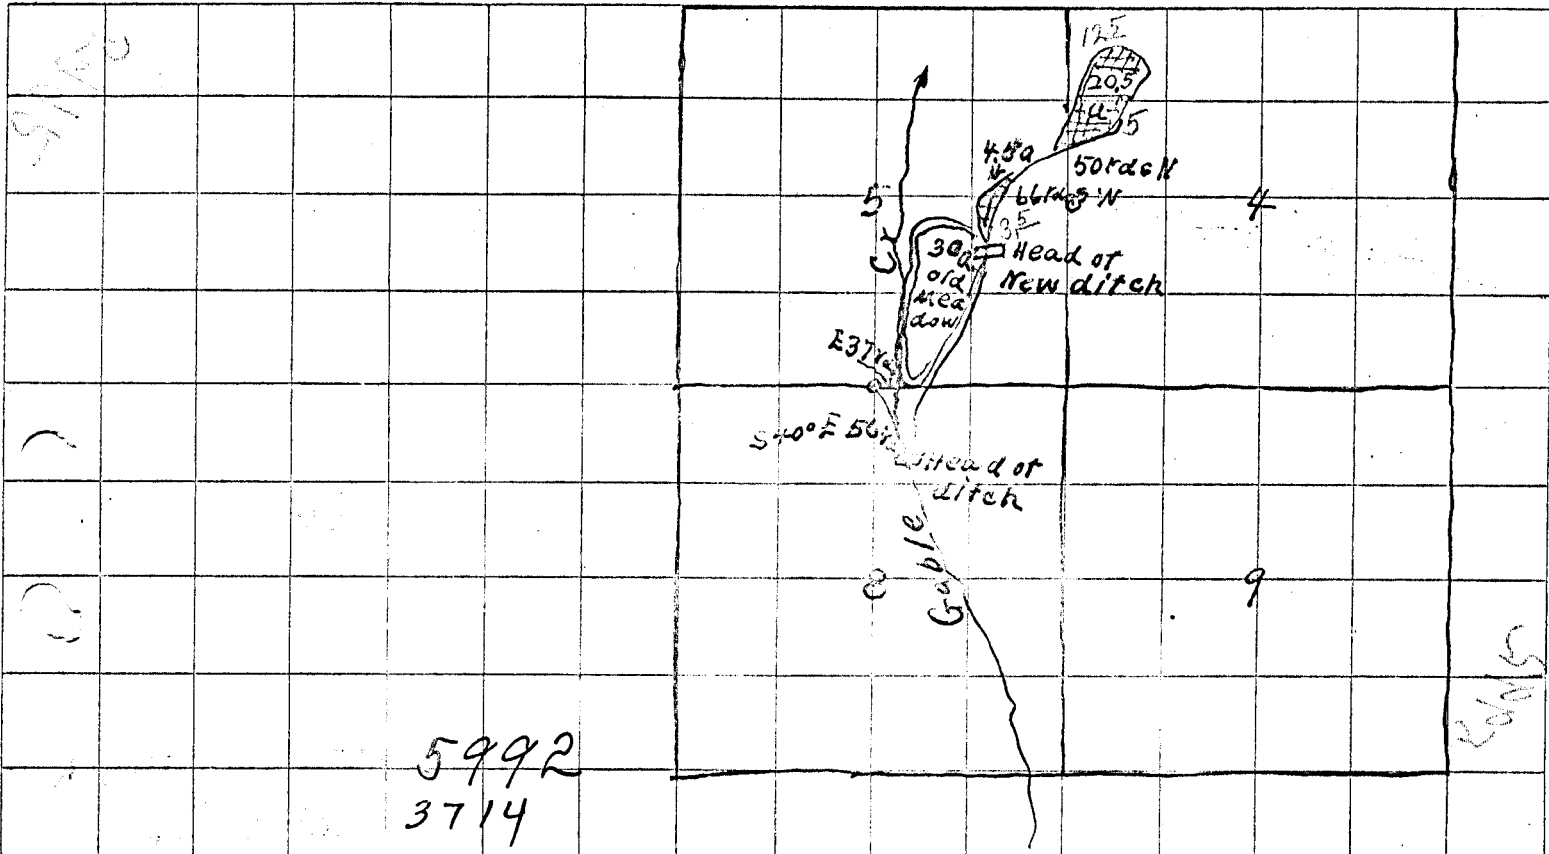

5992
3714

I O. M. Gillenwater of Mitchell, Oregon,
 do hereby certify that this map was made
 from notes taken during an actual
 survey made by me Feb 7, 1918 and that
 it correctly represents the work described
 in the accompanying applications
 together with the location of streams
 and other ditches in the immediate
 vicinity and has written thereon
 the area in the smallest legal
 subdivision which it is proposed
 to irrigate
 O. M. Gillenwater
 Surveyor.

○ = Old Meadow

= Land to be Irrigated

Location of Land to be Irrigated

3.5 acres	in NE ⁴ SE ⁴	Sec 5
4 "	" SE ⁴ NE ⁴	" 5
5 "	" SW ⁴ NW ⁴	" 4
12.5 "	" NW ⁴ NW ⁴	" 4
Total	20 acres	