

Sec. 3

4

9

10


Tp. 1 South

R. 17 E W 1/4

Per

9527

10738

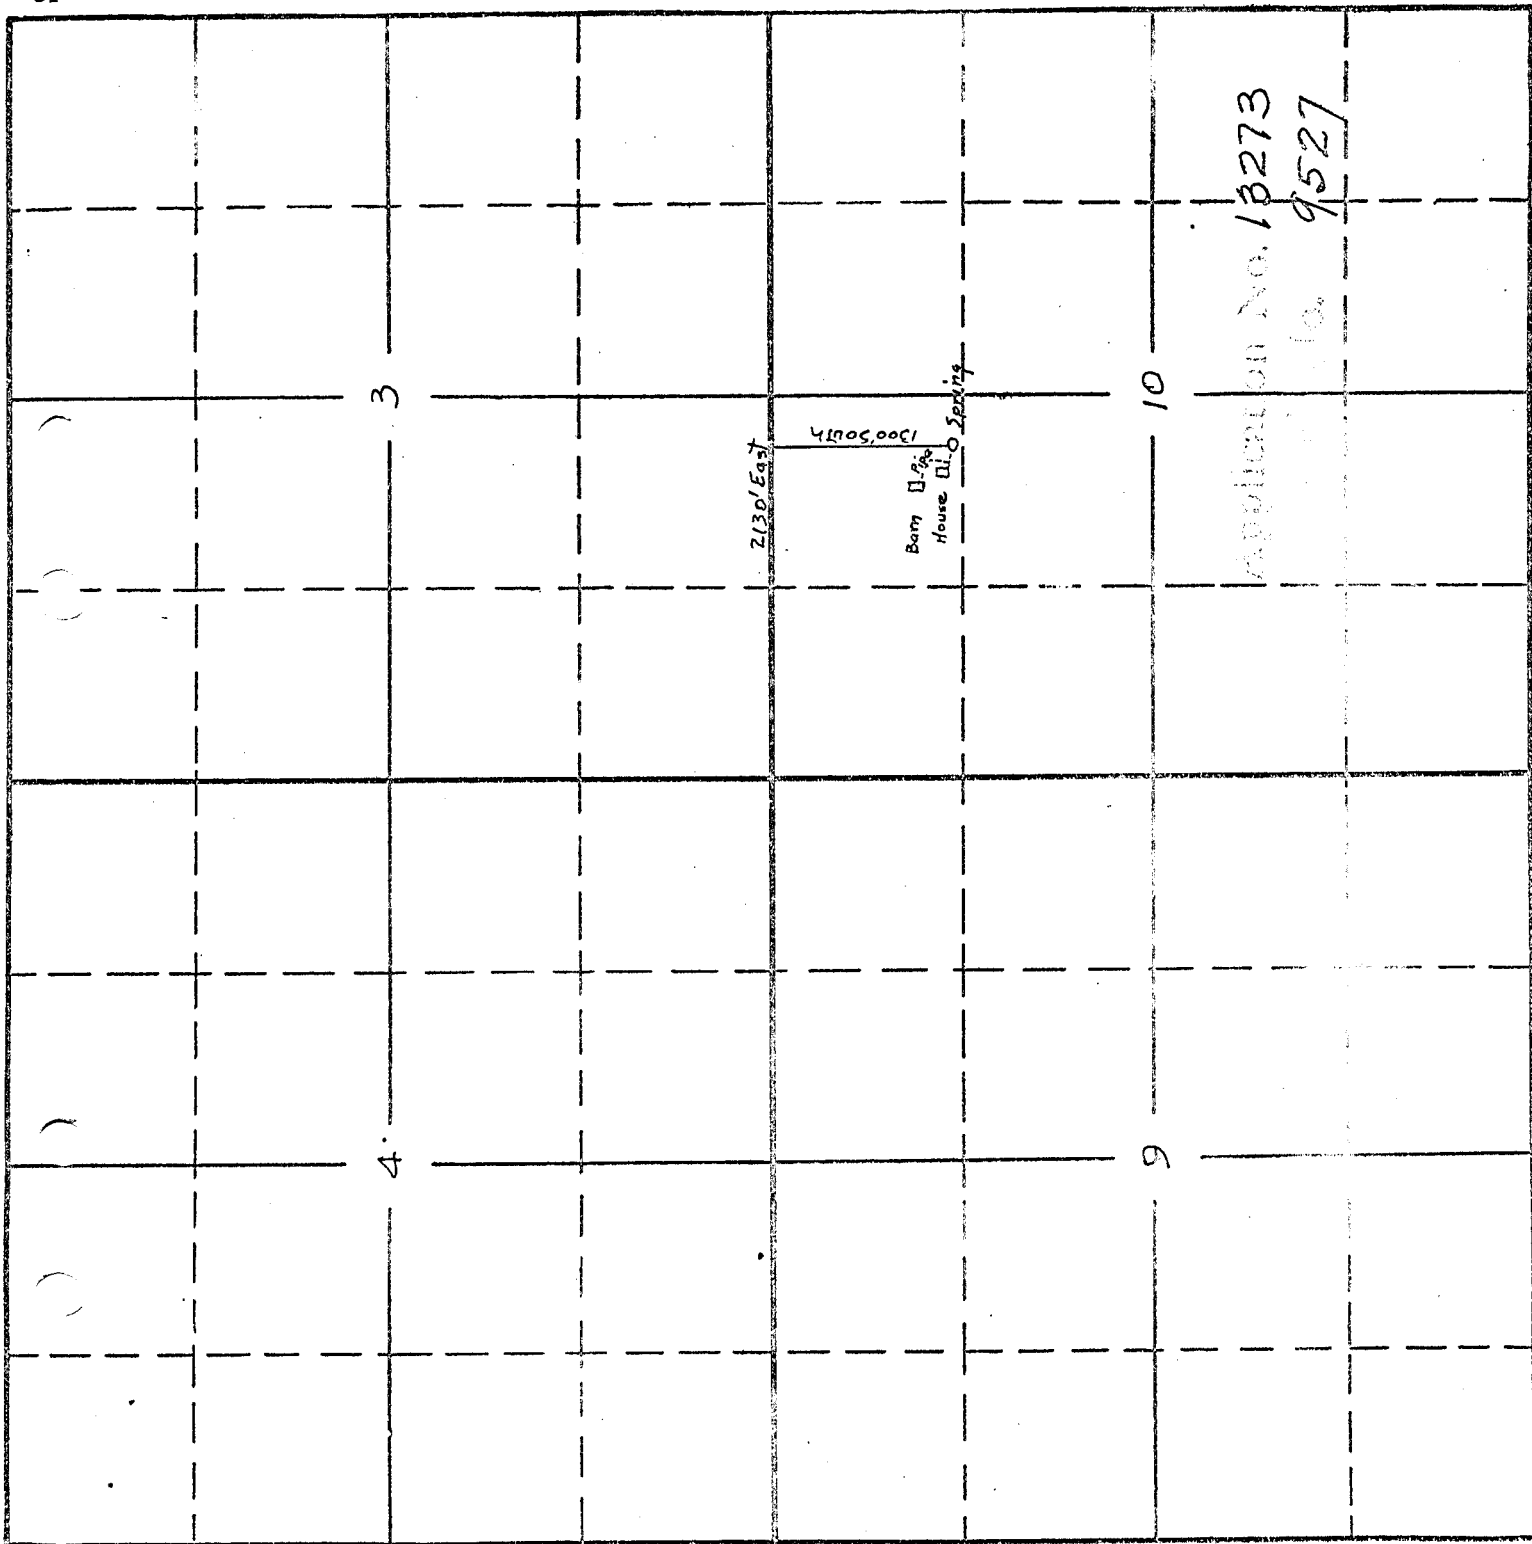

Application No. 13273

9527