


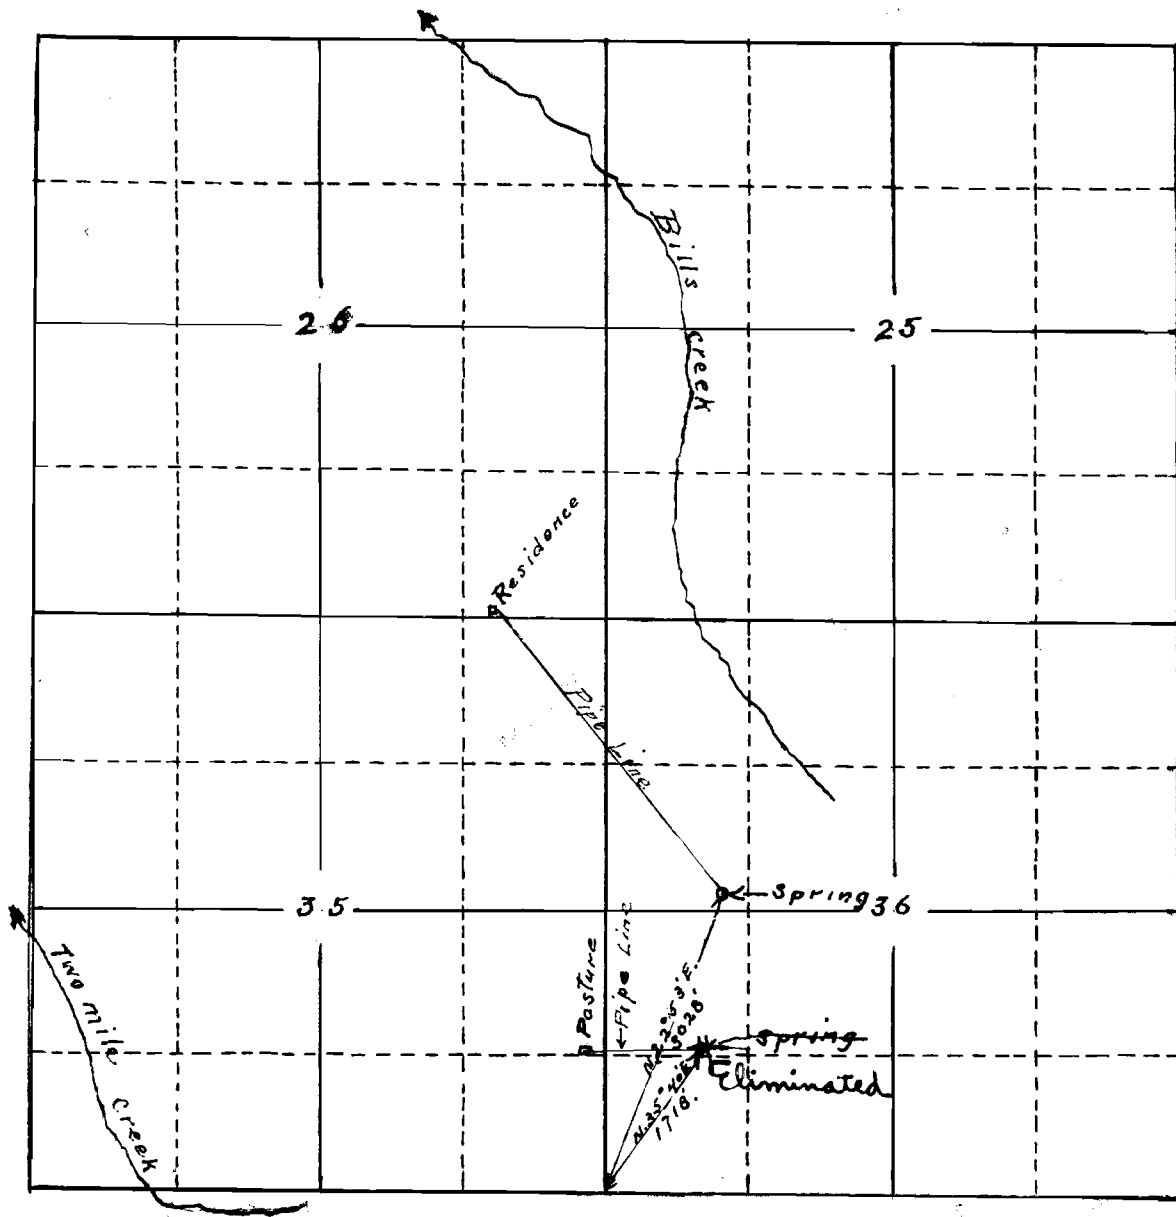

Application No. 13178
Permit No. 9591

T. 29 S.

R. 14 W. W. M.

I, C. S. McCulloch, of Bandon, Oregon, do hereby certify that this map was made from notes taken during an actual survey made by me on Dec. 3rd 1929, and that it correctly represents the work described in the accompanying application, together with the location of streams and other ditches in the immediate vicinity.

C. S. McCulloch

Registered Prop. Engineer

Oregon No. 620 Dec. 8th 1919.