


P- 9907  
10749

Sec. 36  
Tp. 13  
R. 34

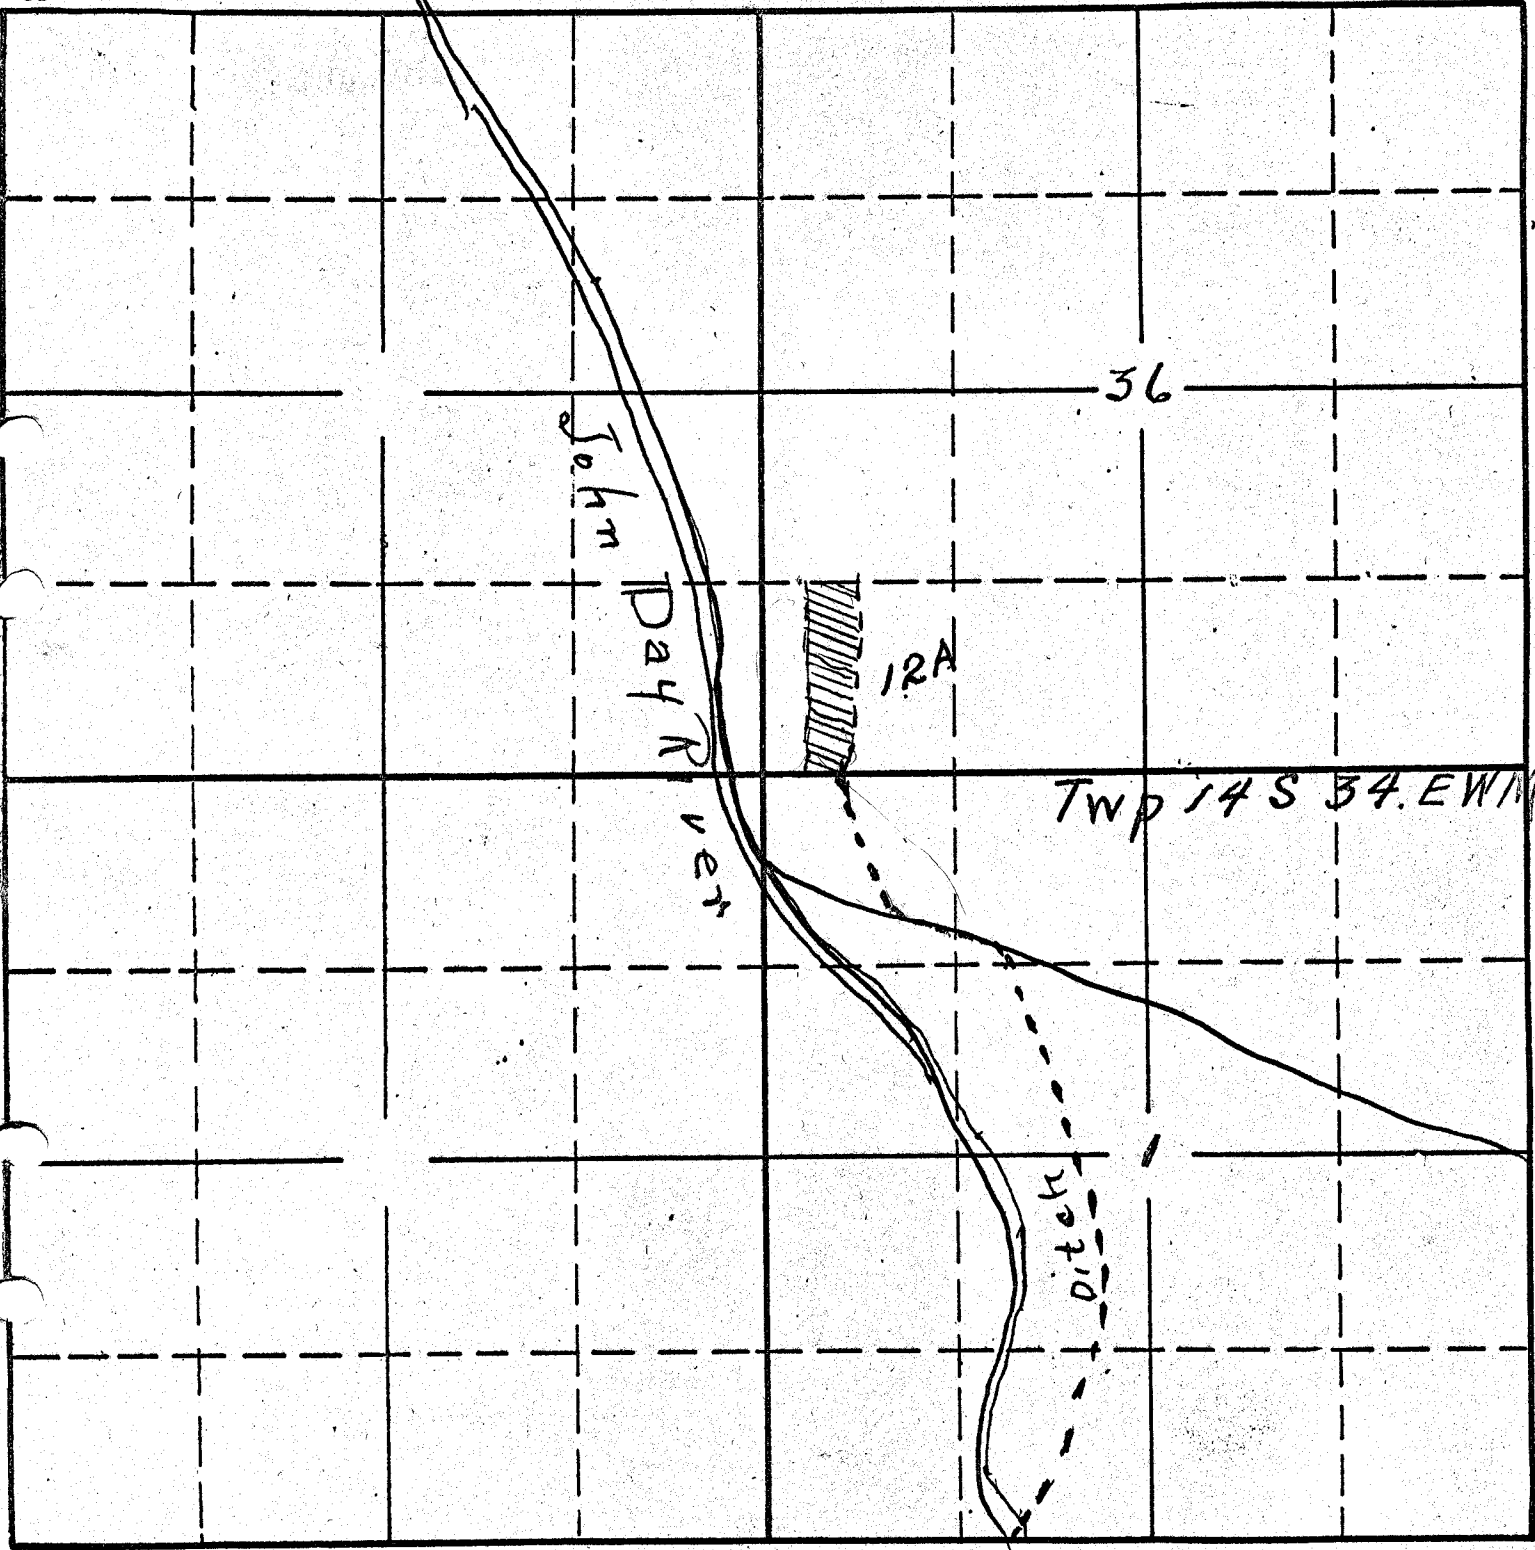

Application No. 13786  
Permit No. 9907