


Sec. 32  
SW ¼ of  
SE ¼

Tp. 3 S.  
R. 1 E.

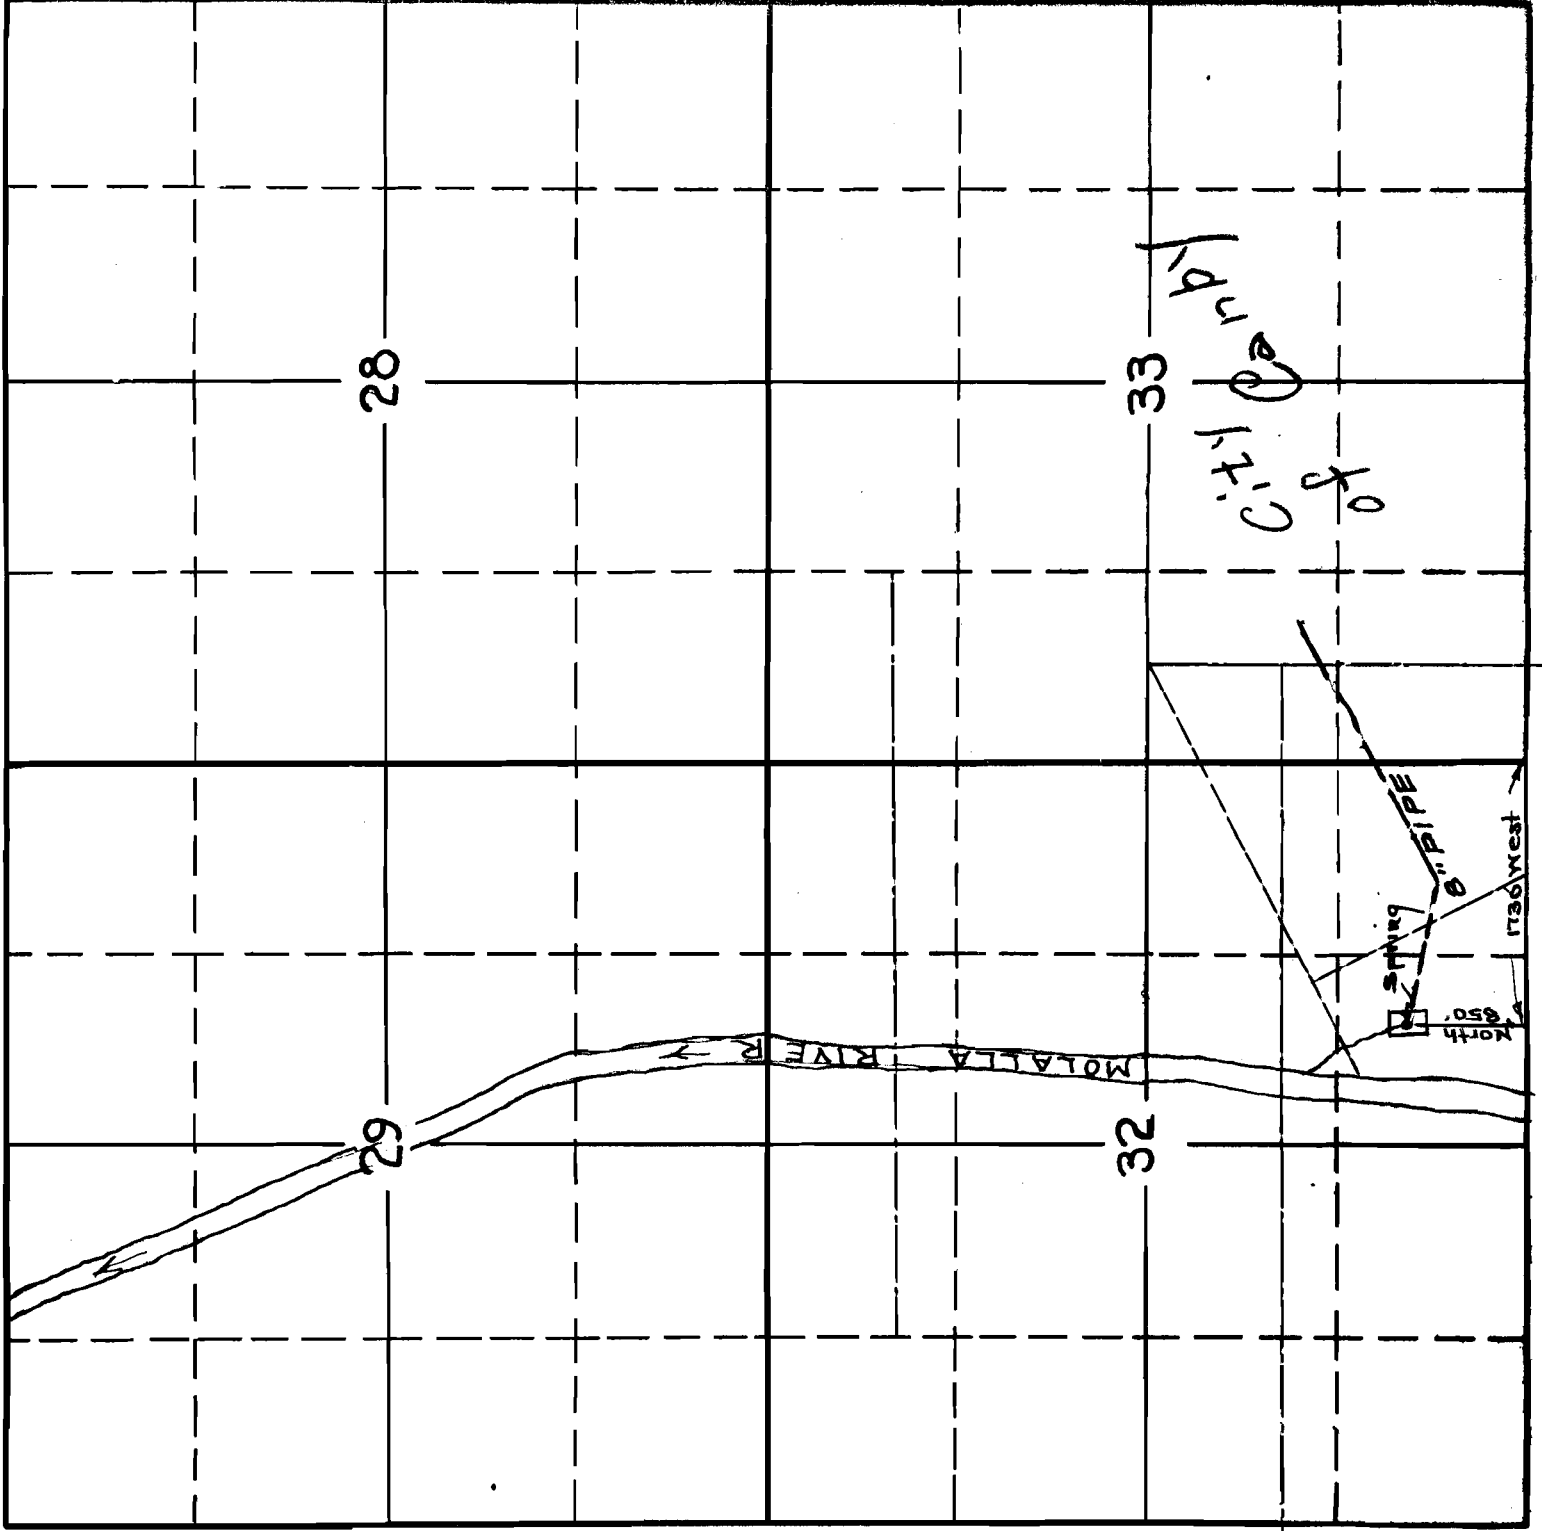

App. No. 15085  
Per. No. 11011

NOTE  
Spring is located  
in the SW ¼ of the  
SE ¼ of Section  
32 T.3S. R.1E. 11M.  
at a point that is  
850 feet North  
and 1730 feet West  
of the SE. Corner  
of Sec. 32

STATE ENGINEER  
RECEIVED  
AUG 16 1933  
SALEM, OREGON