


Per # 8848
16784

Twp 10S R 27E Sec 5 4 9

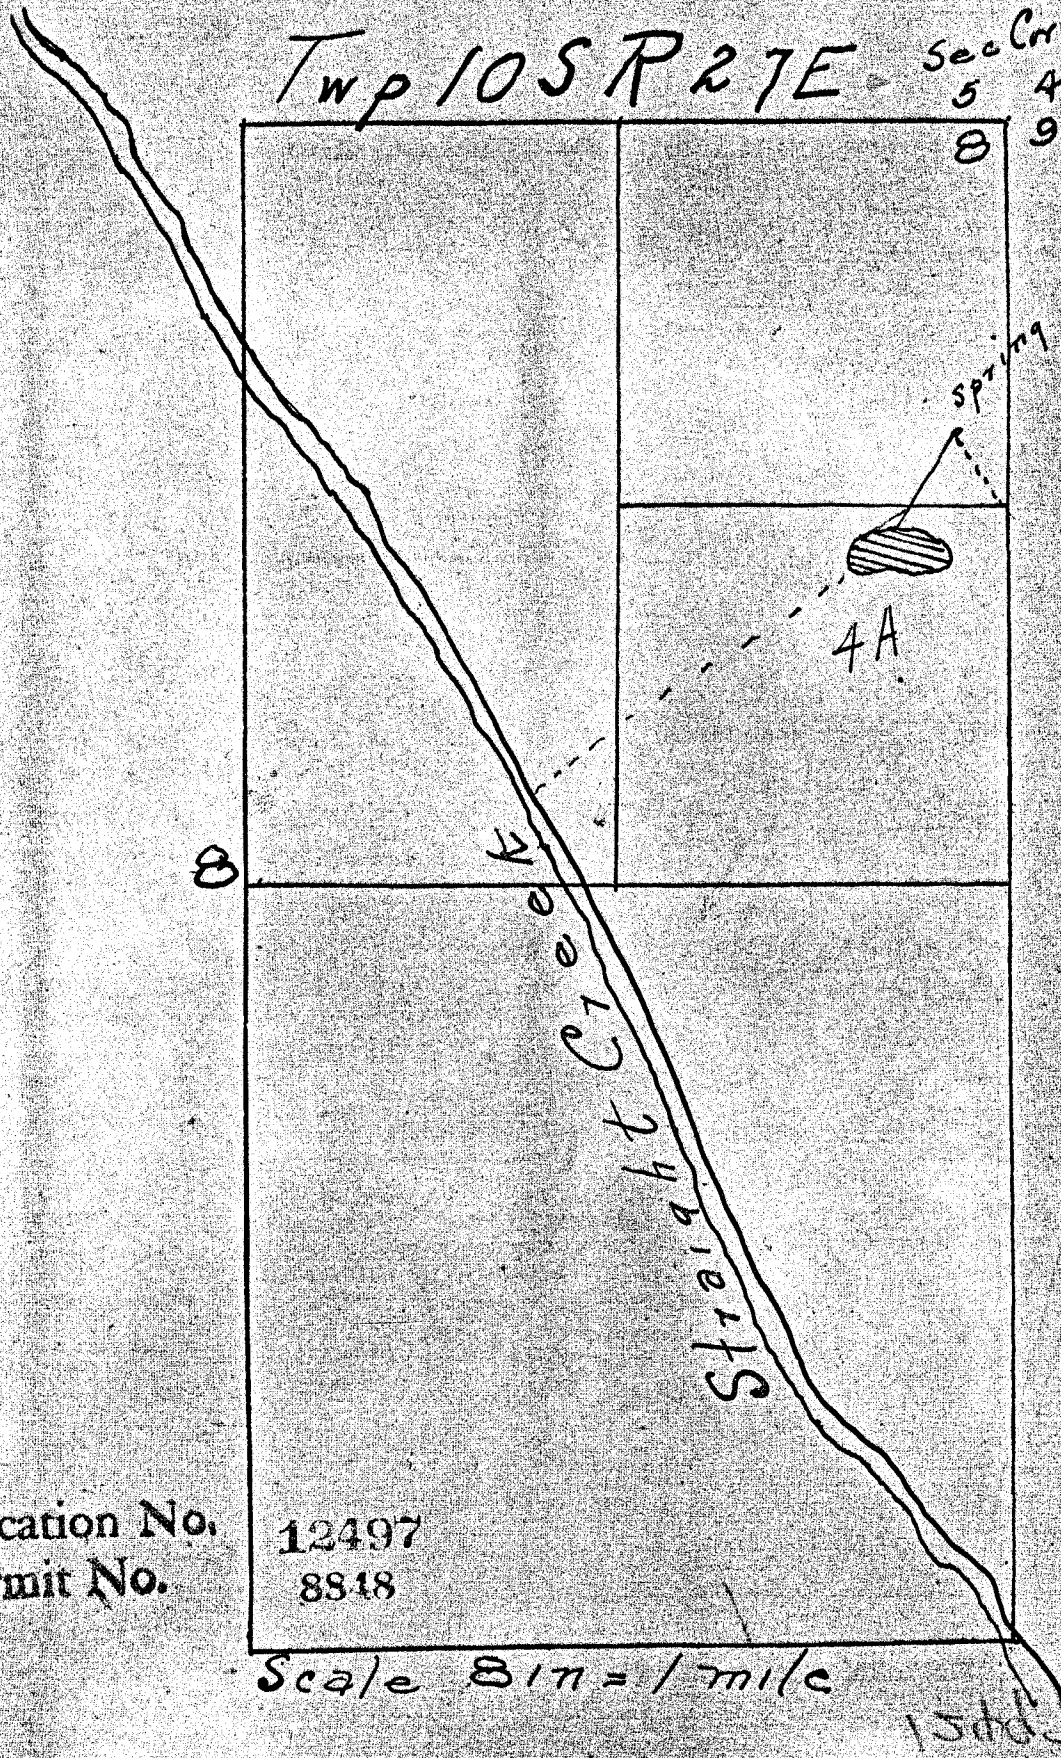

Application No.
Permit No.

12497
8848

Scale 8 in = 1 mile

15th