


SURVEY IN N.Y. 1/4, N.Y. 1/4, SECT. 7, TWP. 2 N., RANGE 8, EAST W. M.

FOR J.H. & Lucy MARTINSEN  
N.Y. COR. SEC. 7.

DATE 3/17/30

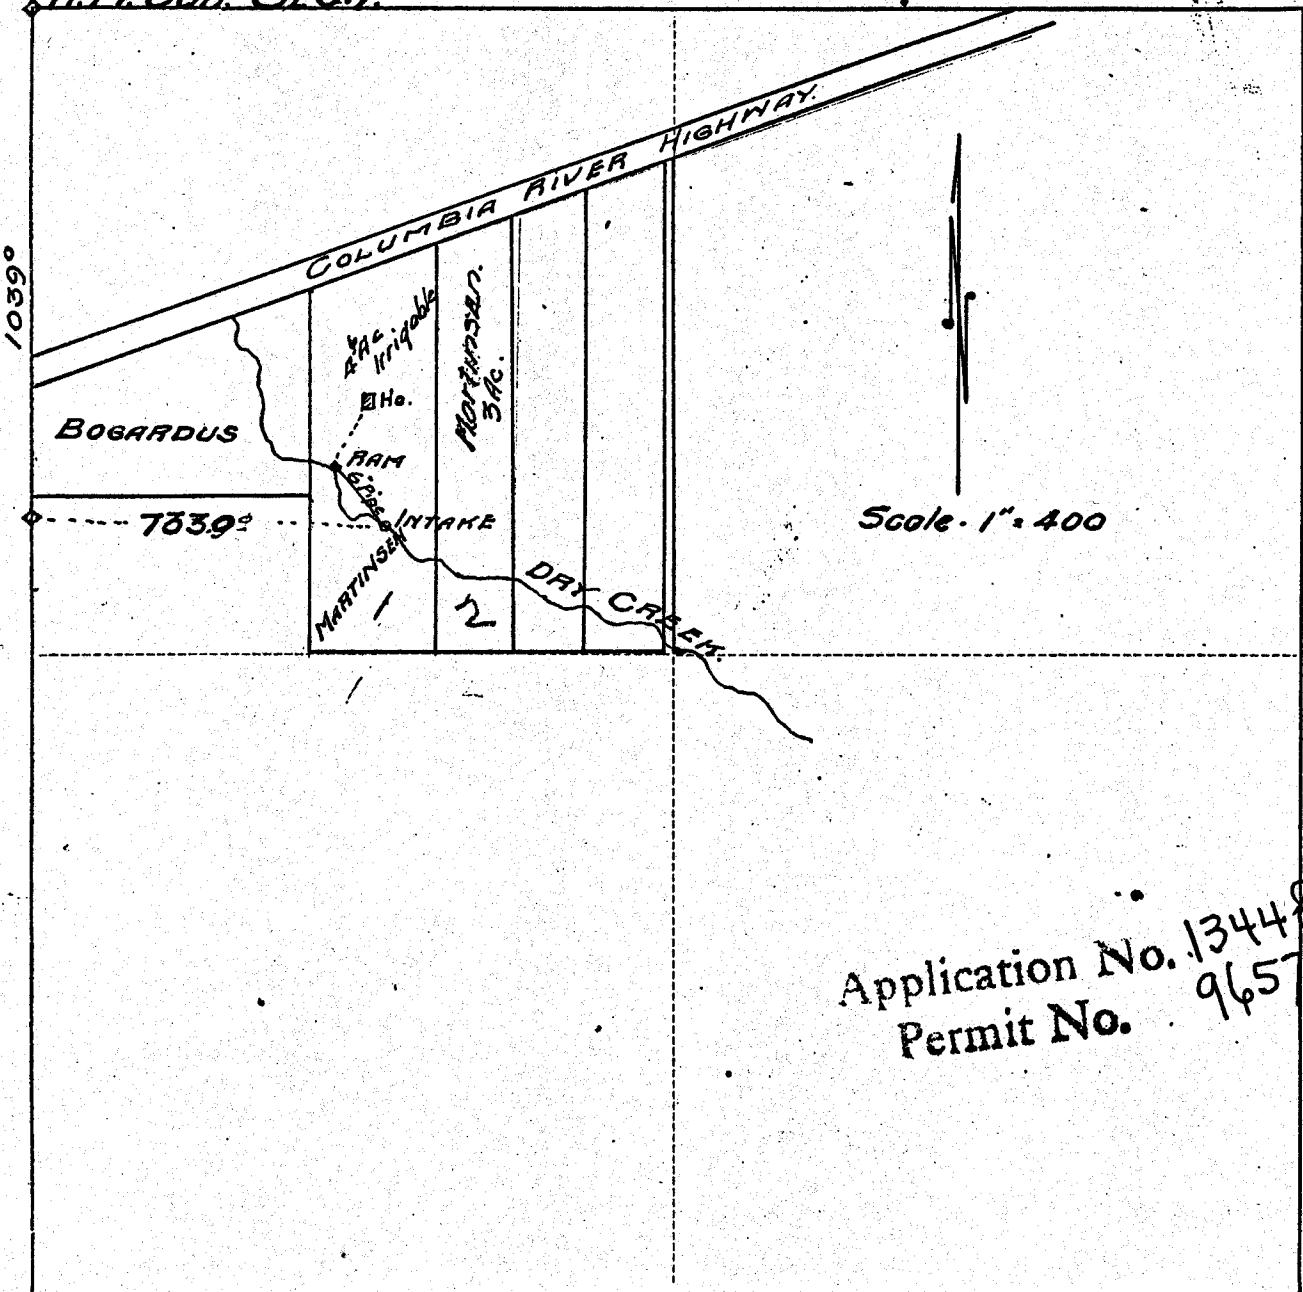

I do hereby certify that this sketch was made from notes taken during an actual survey made by me on March 17 1930, and that it correctly represents field work of said survey.

C. M. Hubbard  
County Surveyor  
Hood River County, Oregon

Helpers J.H. MARTINSEN