


Filing of Edwin A Abbott.
on Spring in Sec. 34.
Twp 16 South, Range 18 E W.M.

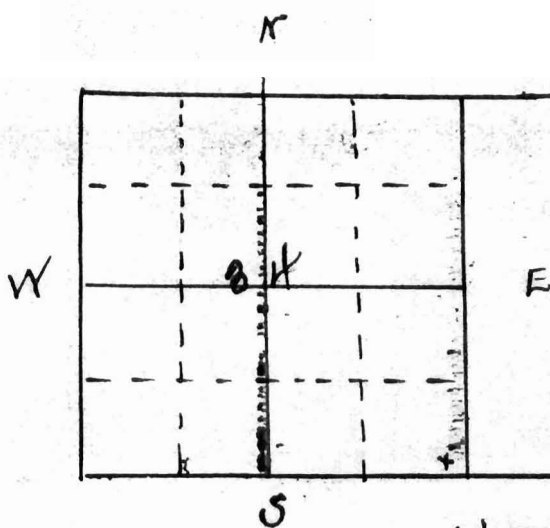

X Location of Spring

OFFICE OF STATE ENGINEER
RECEIVED
OCT 28 1920
SALEM, OREGON

Application No. 2508
Permit No. 4833