


Per # 9267

10863

Twp 10 SR 30 E W.M

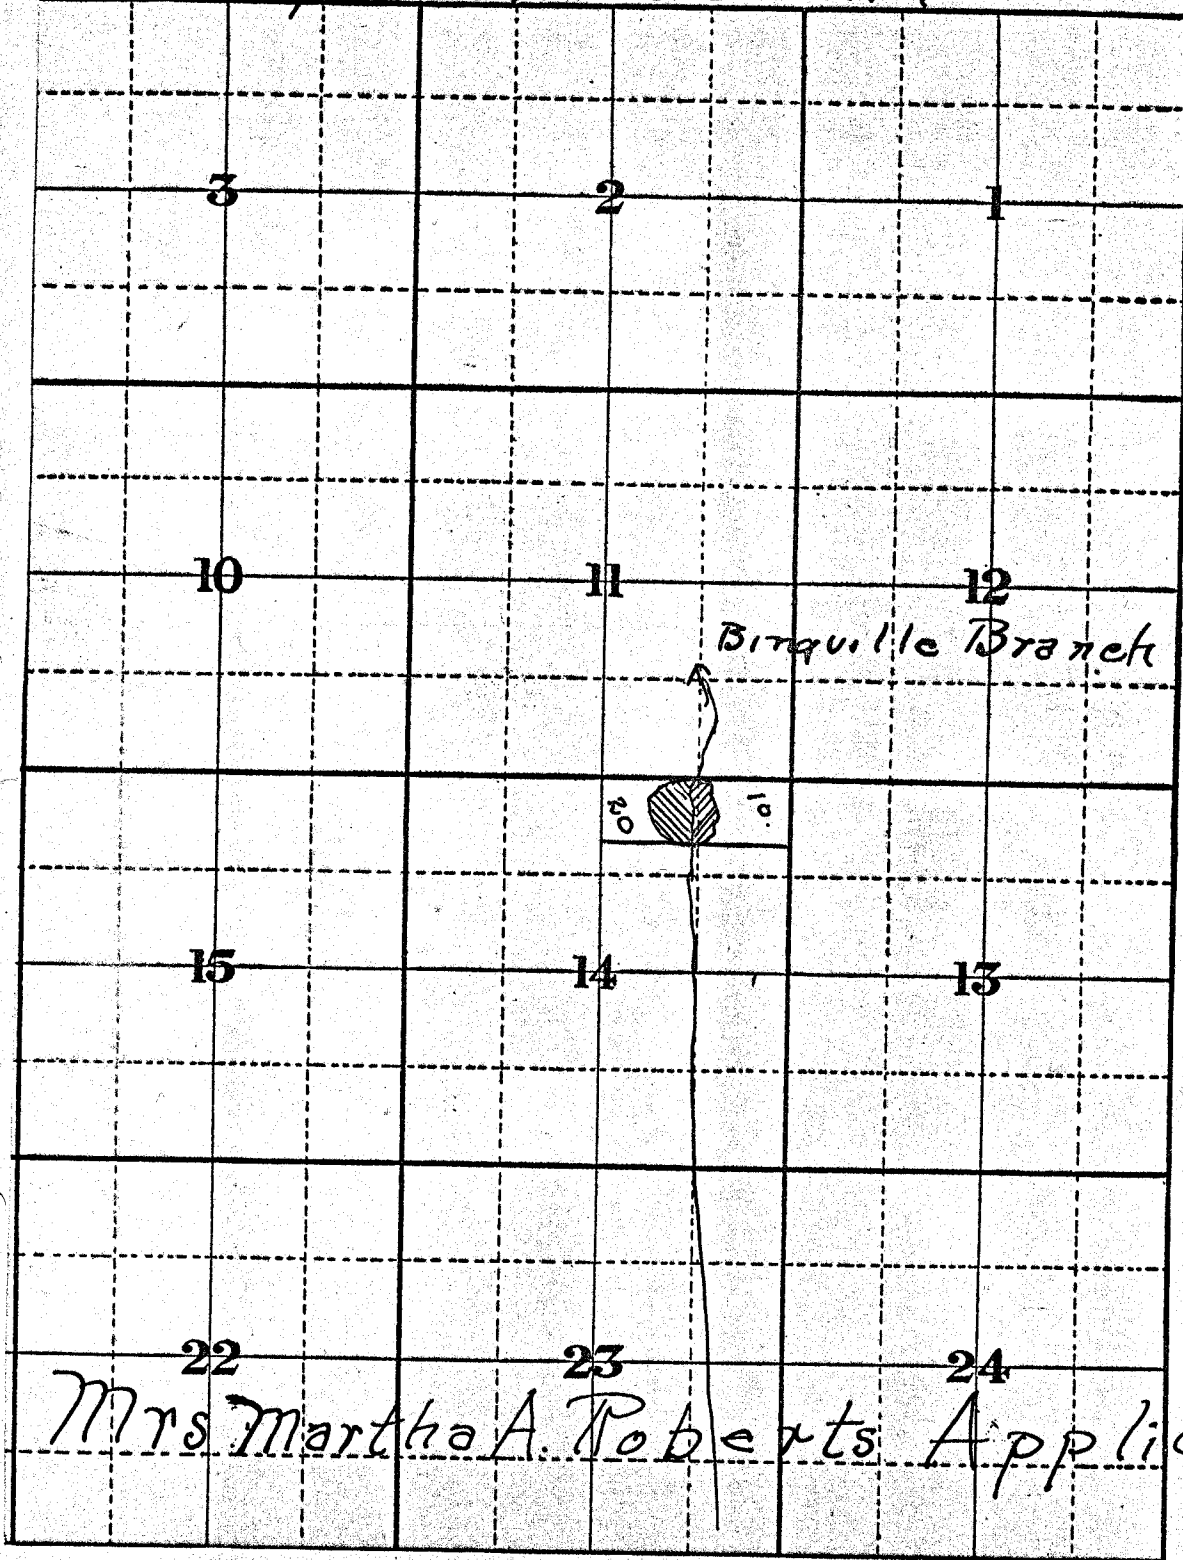

Application No. 12952

Permit No. 9267