


T.14S.,R.14E.,W.M.

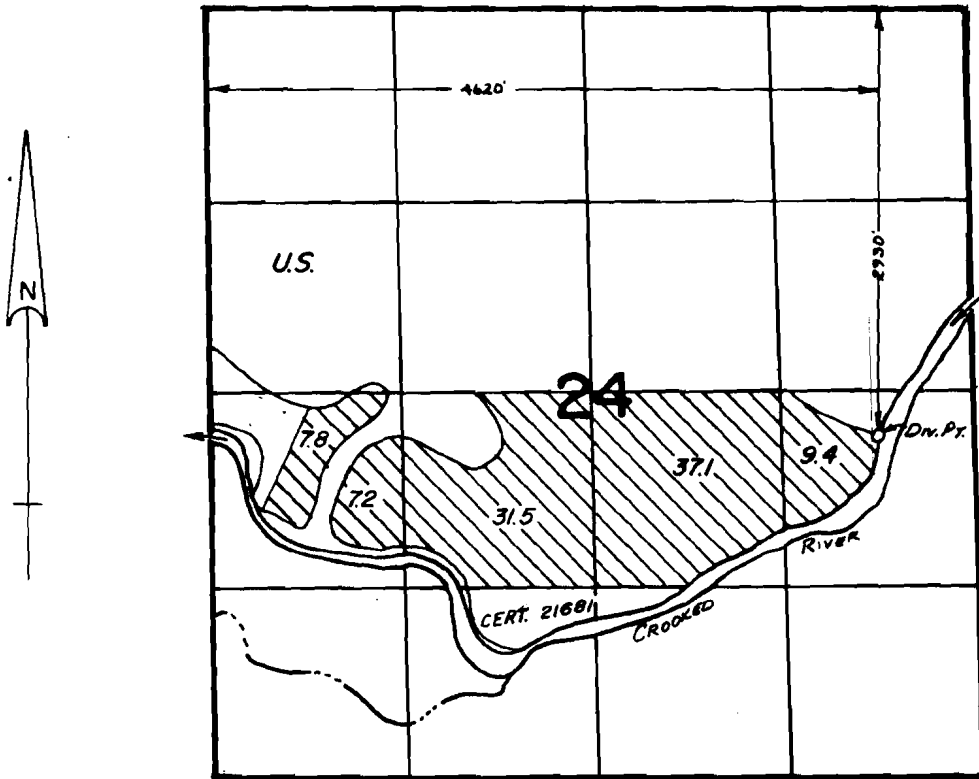

SCALE: 1" = 1320'

**FINAL PROOF SURVEY**  
UNDER

Transfer No. 3743  
Application No. .... Permit No. ....  
IN NAME OF

.....**RAFTER...O...CATTLE...CO.**.....

Surveyed ..JULY...27. 19.79., by ..L.H.NUNN.....

10868  
521813  
T3743

9561