


T. 14 S., R. 34 E., W. M. P 11231
16891

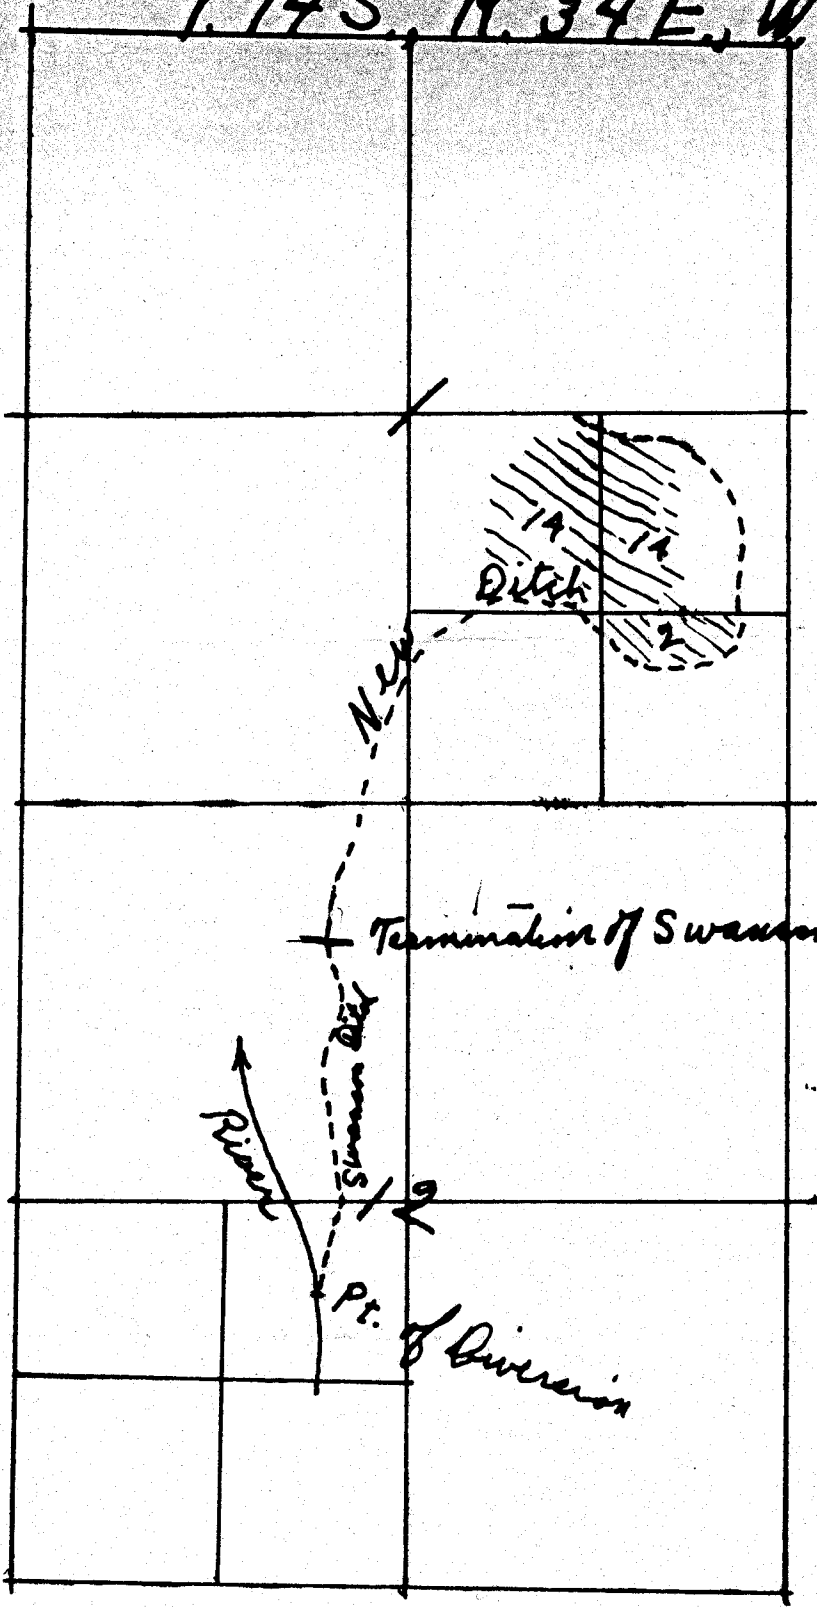

RECEIVED
APR 4 1934
STATE ENGINEER
SALEM, OREGON

App. No. 15323
Per. No. 11231