


TOWNSHIP 33S. RANGE 7E

13-17

5. 3. 1

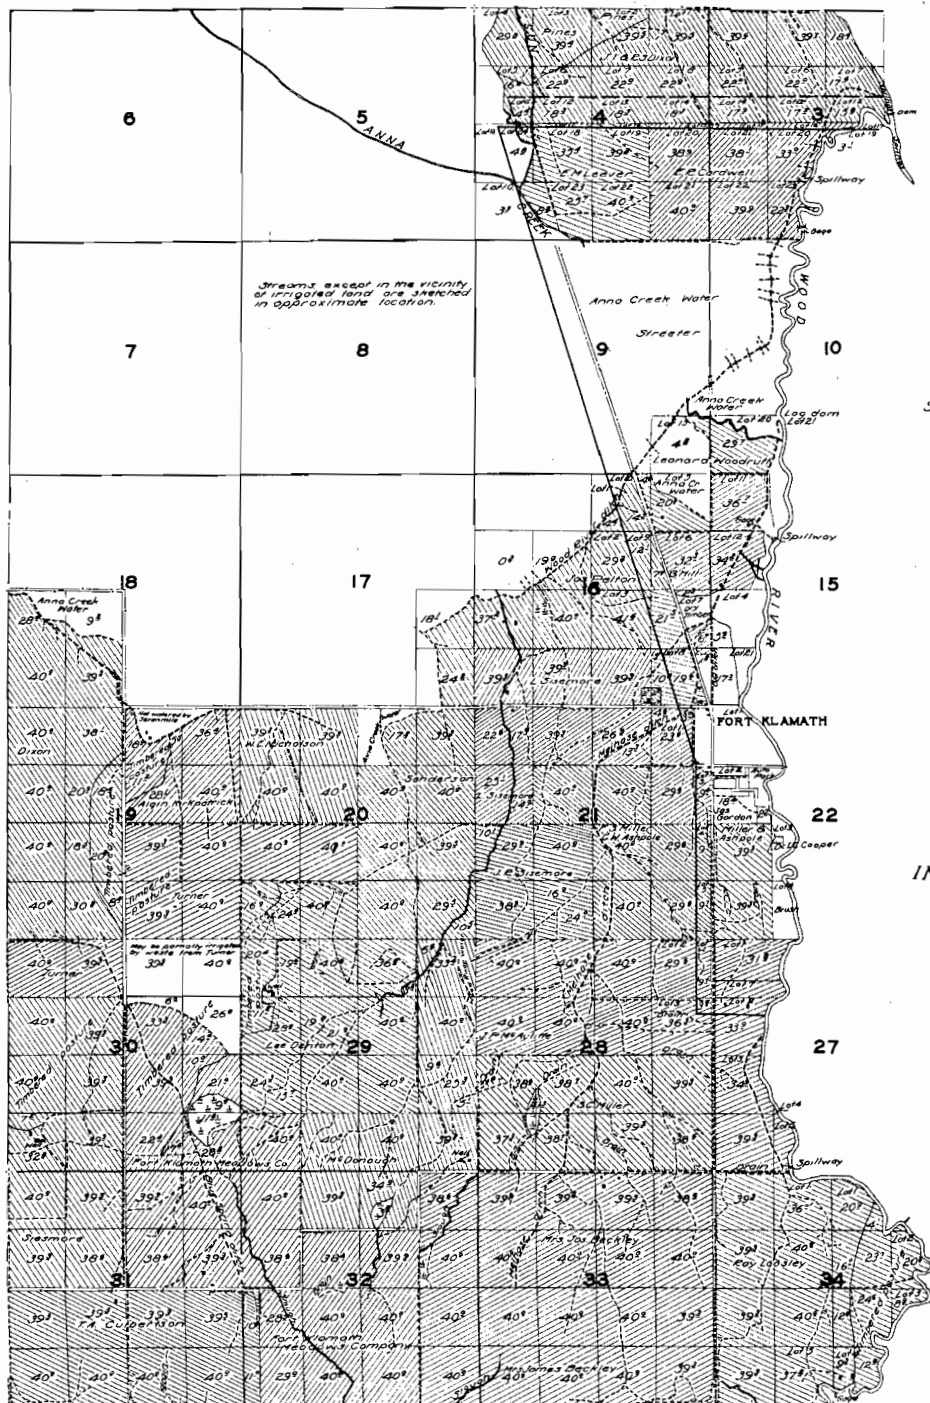

Surveyed July 9 to July 30 1927

INDIAN RESERVATION

Total land irrigated on this sheet 25,000 +

31-3-4