



Township 2 S.

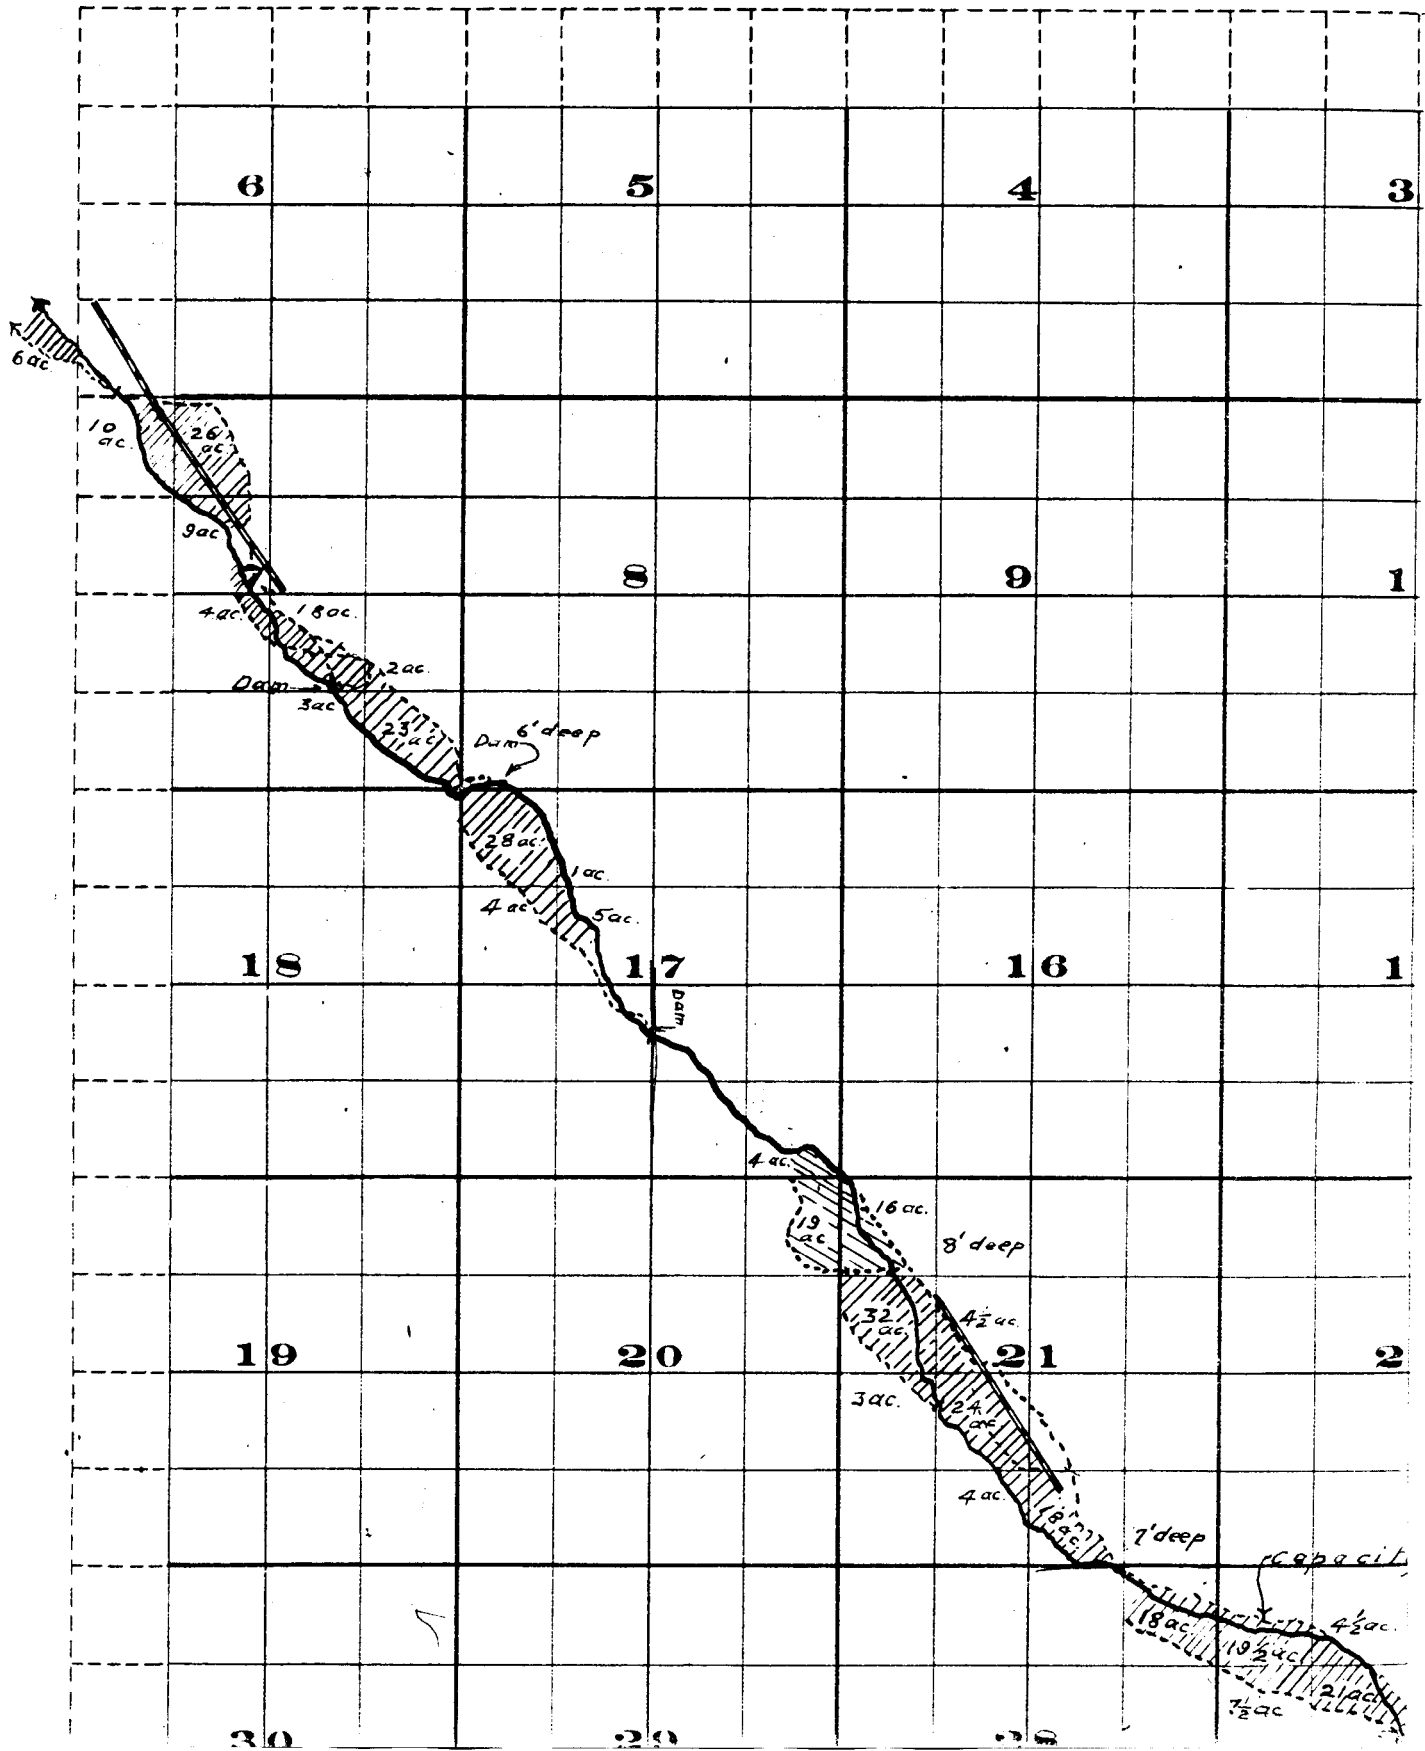

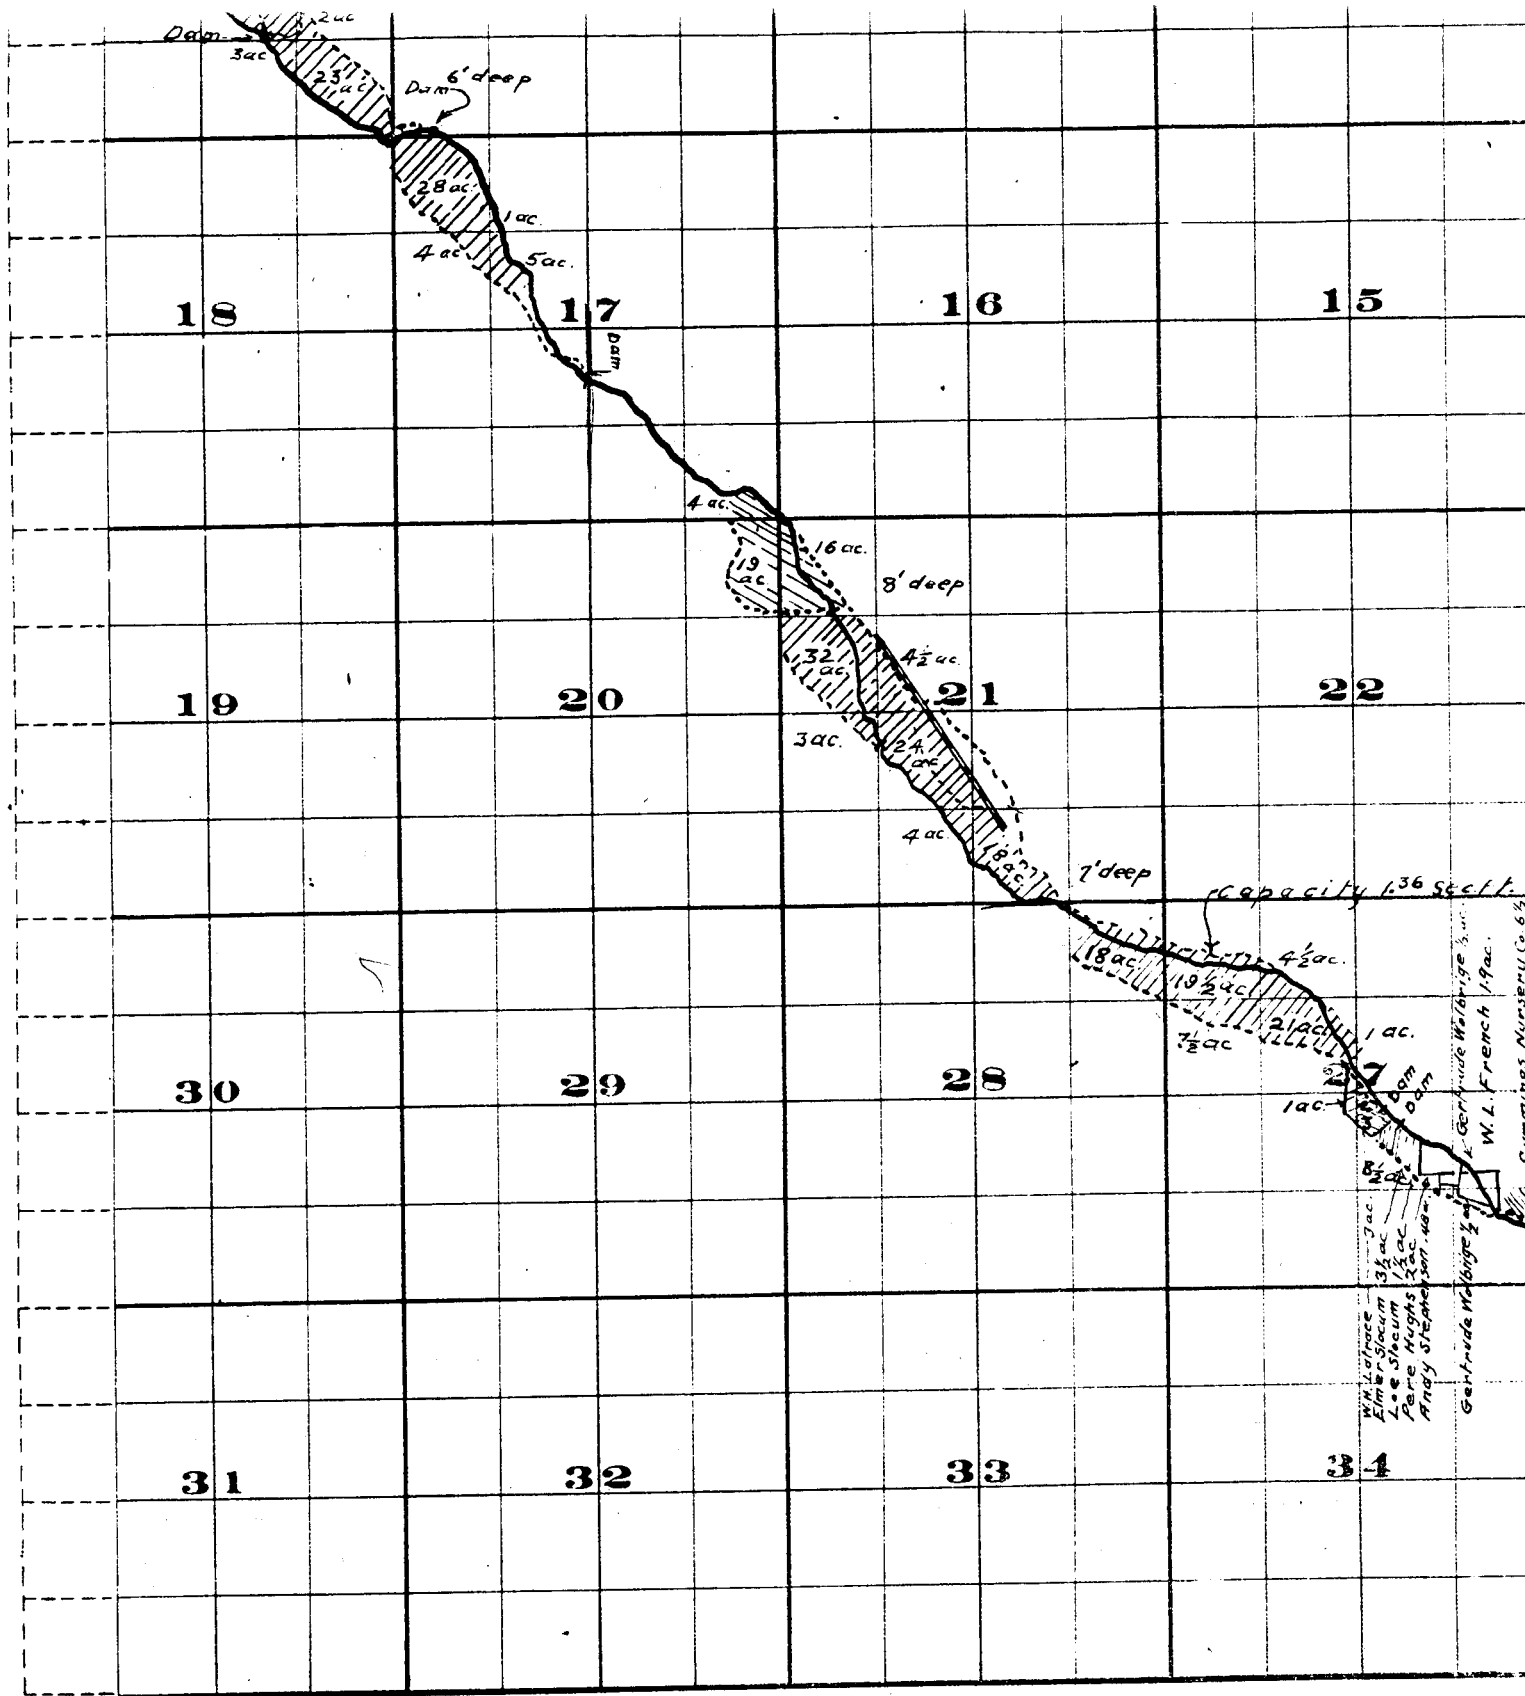

THE B. & B. BRISTOL CO., PRINTERS & BOOK-BINDERS CHICAGO, ILL.

Surveyed by R.D. Cooper July 1909
 John H. Lewis - State Engineer.
 Examined July 14, 1909.



