


TOWNSHIP 33 S., RANGE 6 E.

31.0.14

12-07

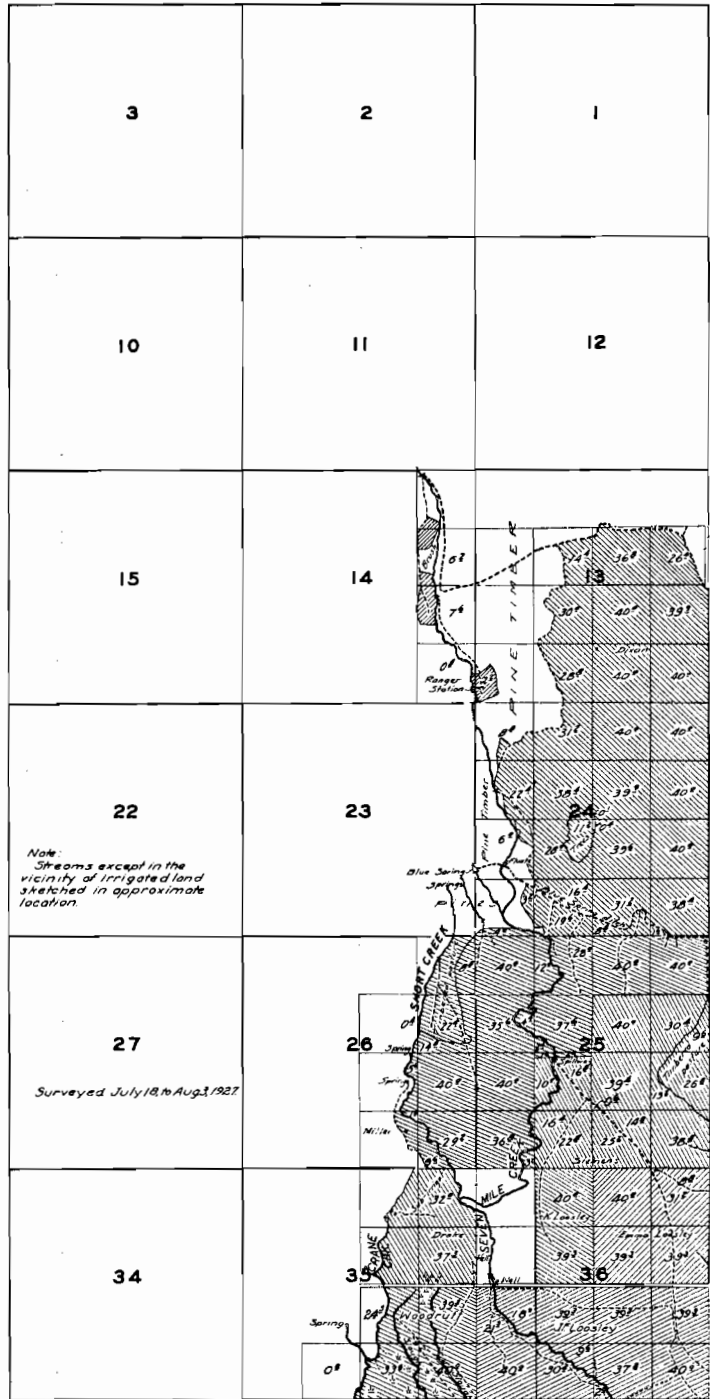

601014
2