


P. 7961
10952

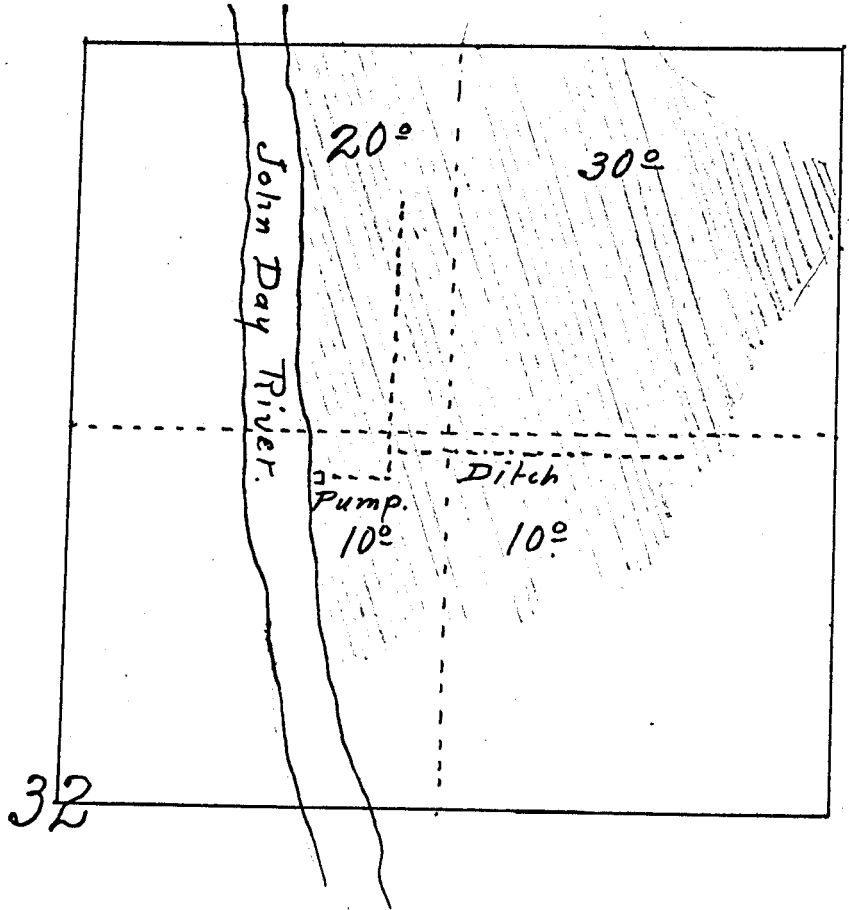

CHAPMAN
Loc 30 1/4 Sec
1-3-18

N.E. 1/4 Sec. 32, T. 7 S. R. 19 E

Charles E. Chapman, Clarno, Ore.

Application No. 11514
Permit No. 7961