


TOWNSHIP 9 S RANGE 35 E

Per 8321
10954

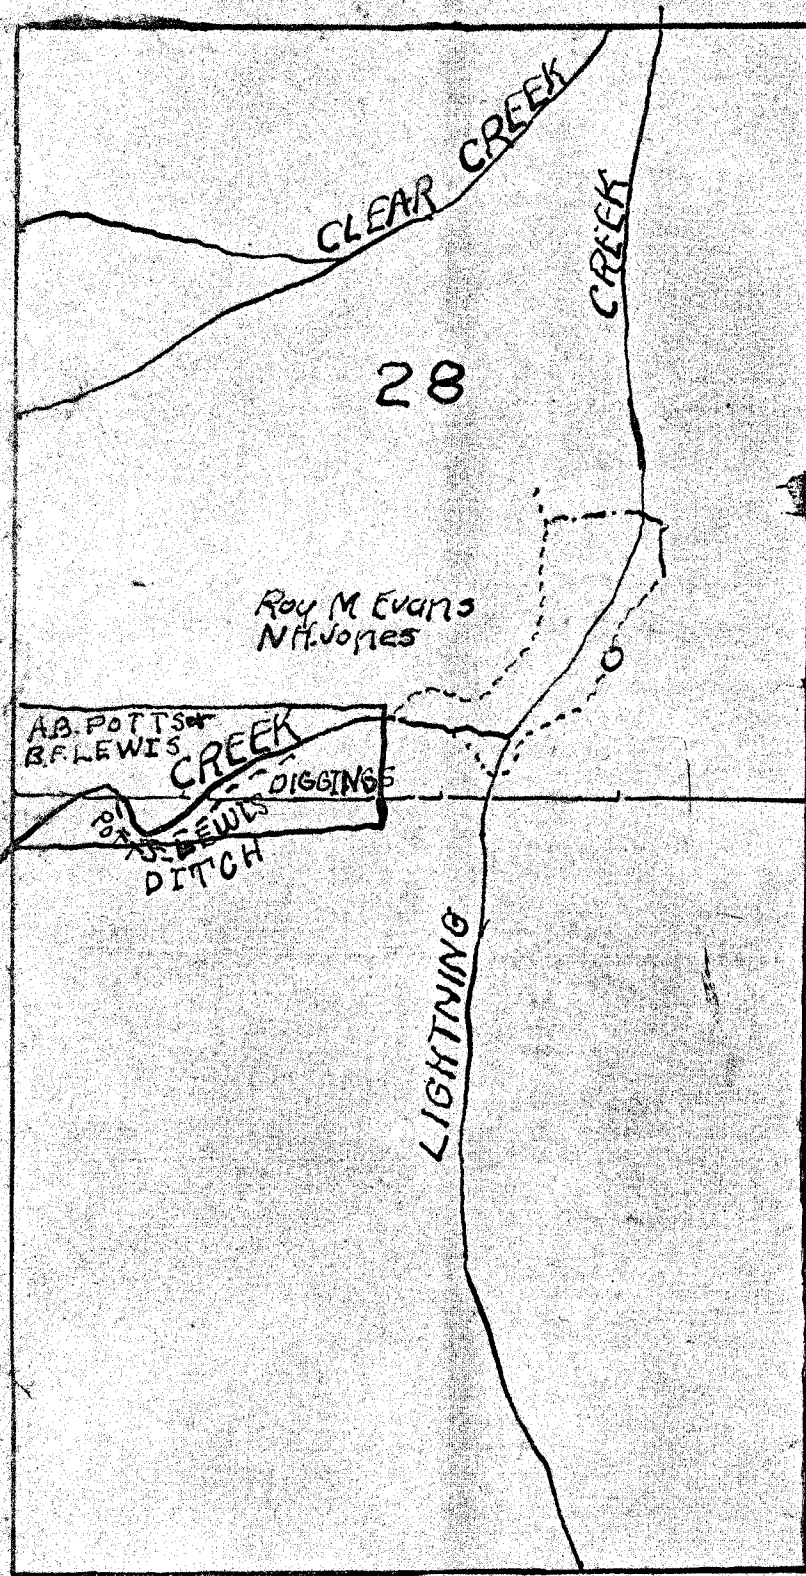

App 11 802
Per 8321

I, F.L. HUBBARD OF BAKER,
OREGON, DO HEREBY CERTIFY
THAT THE FOREGOING IS