

MAP OF DEEP GRAVEL PLACER DITCH

IN SECTIONS 5-4-9 T₁P. 10 S. R. 35 E. W. 11.


GRANT COUNTY, OR.

Scale 1"=300'

June, 18, 1929.

Roscoe Neal, CIVIL ENG.


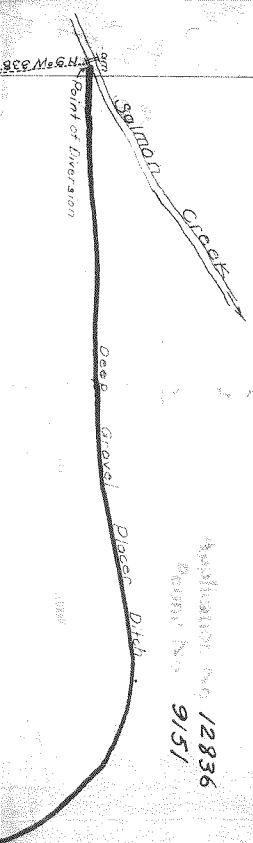

358 M. 6 N.

Lightning

43
96

DEEP GRAVEL PLACER MINE

149.64 Acres

Creek

1/4 Cor

280 9

Roscoe Neal

that this map was made from notes taken
actual survey made by me on June 16, 1920
it correctly represents the works described
company and application, together with the
of streams and other aitches in the immedi-
city

Roscoe Neal

Section line

inversion

Deep gravel
Placed ditch

Application No 12836
Point No 9151

Creek

6

Creek

149.64 Acres

DEEP GRAVEL PLACER MINE

