

Sec. 27

28



34

Tr. 35

R33-70

9168
10961

1096

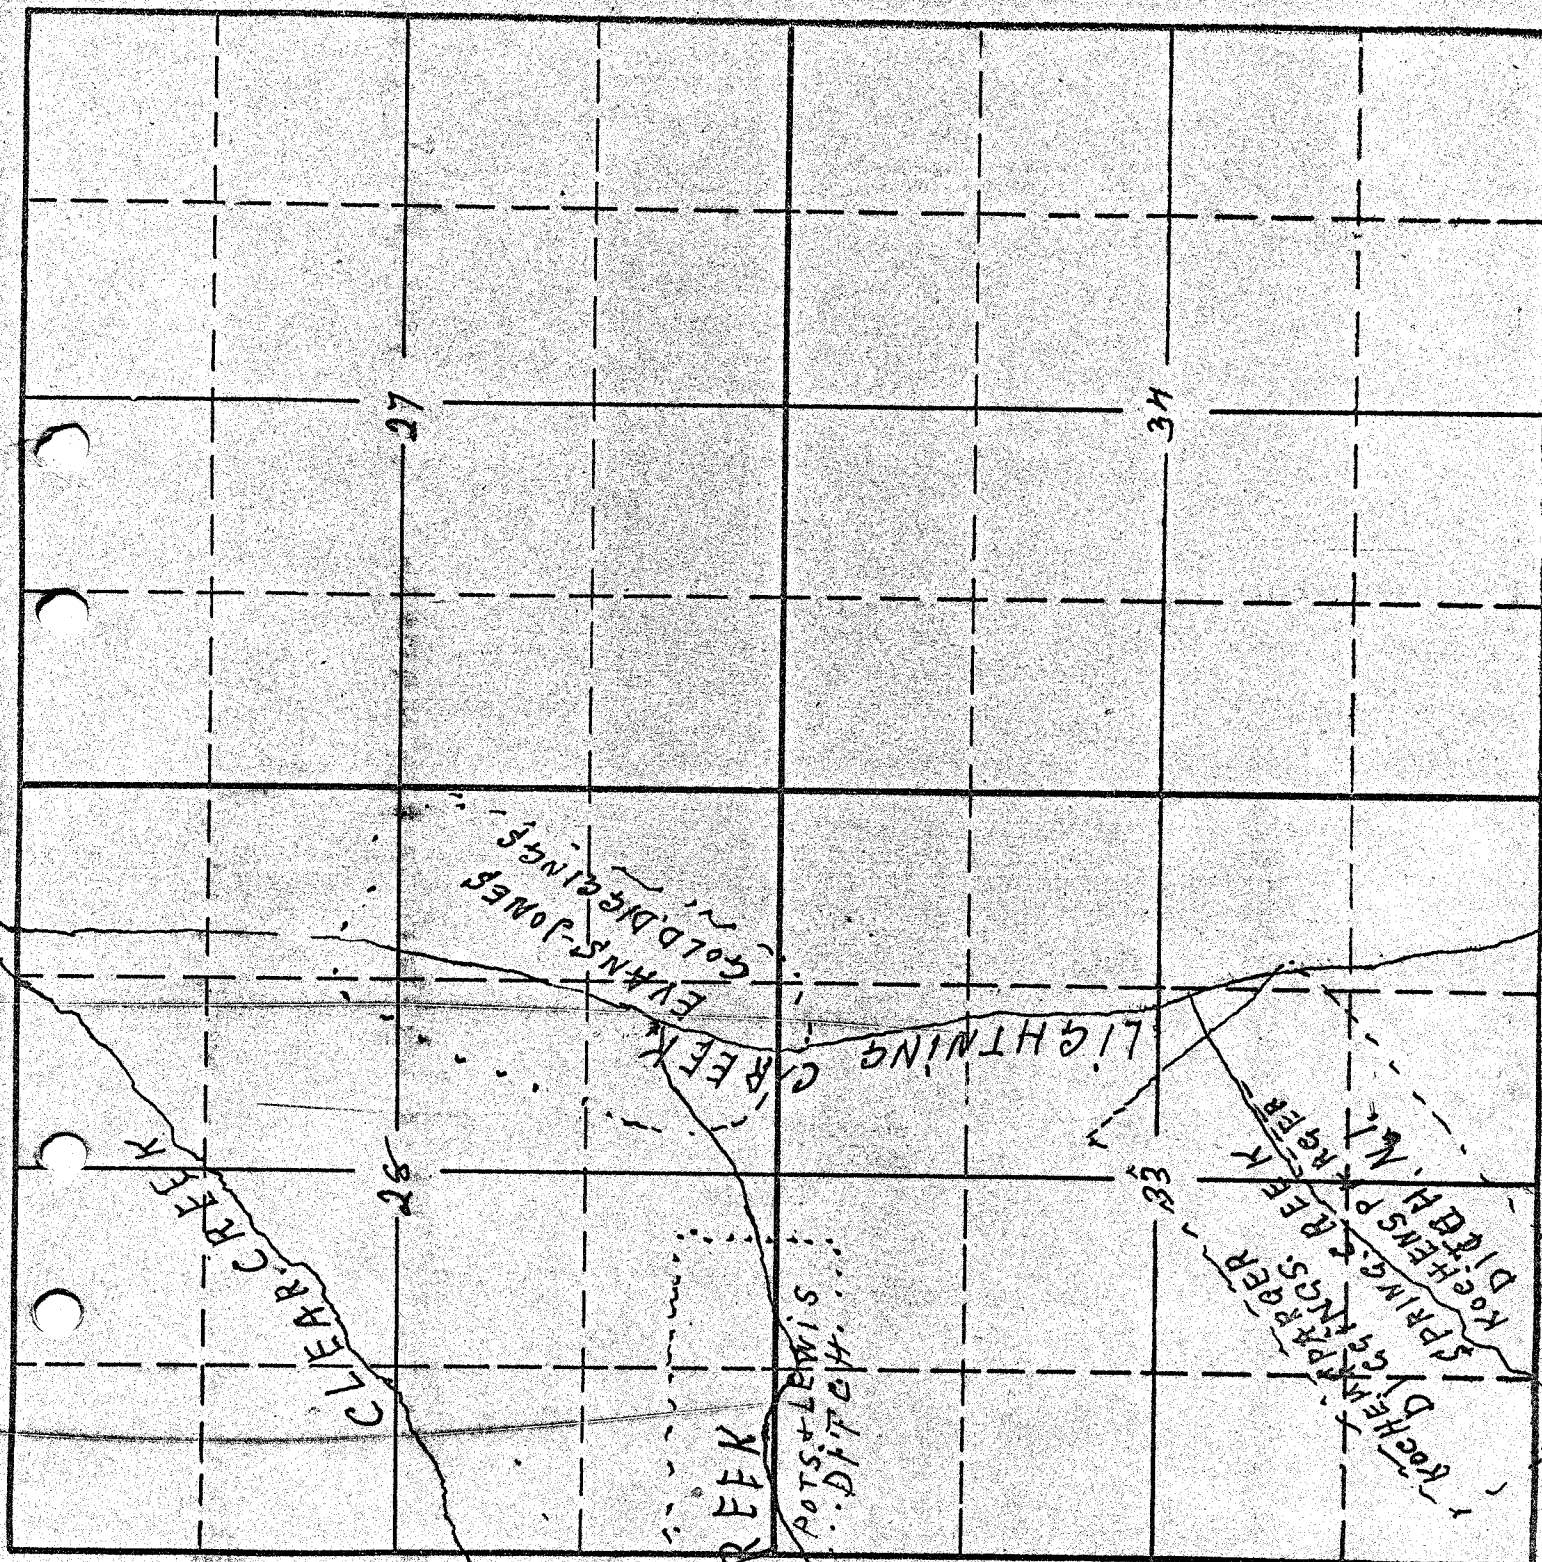

Application No. 12867

Permit No. 9168