


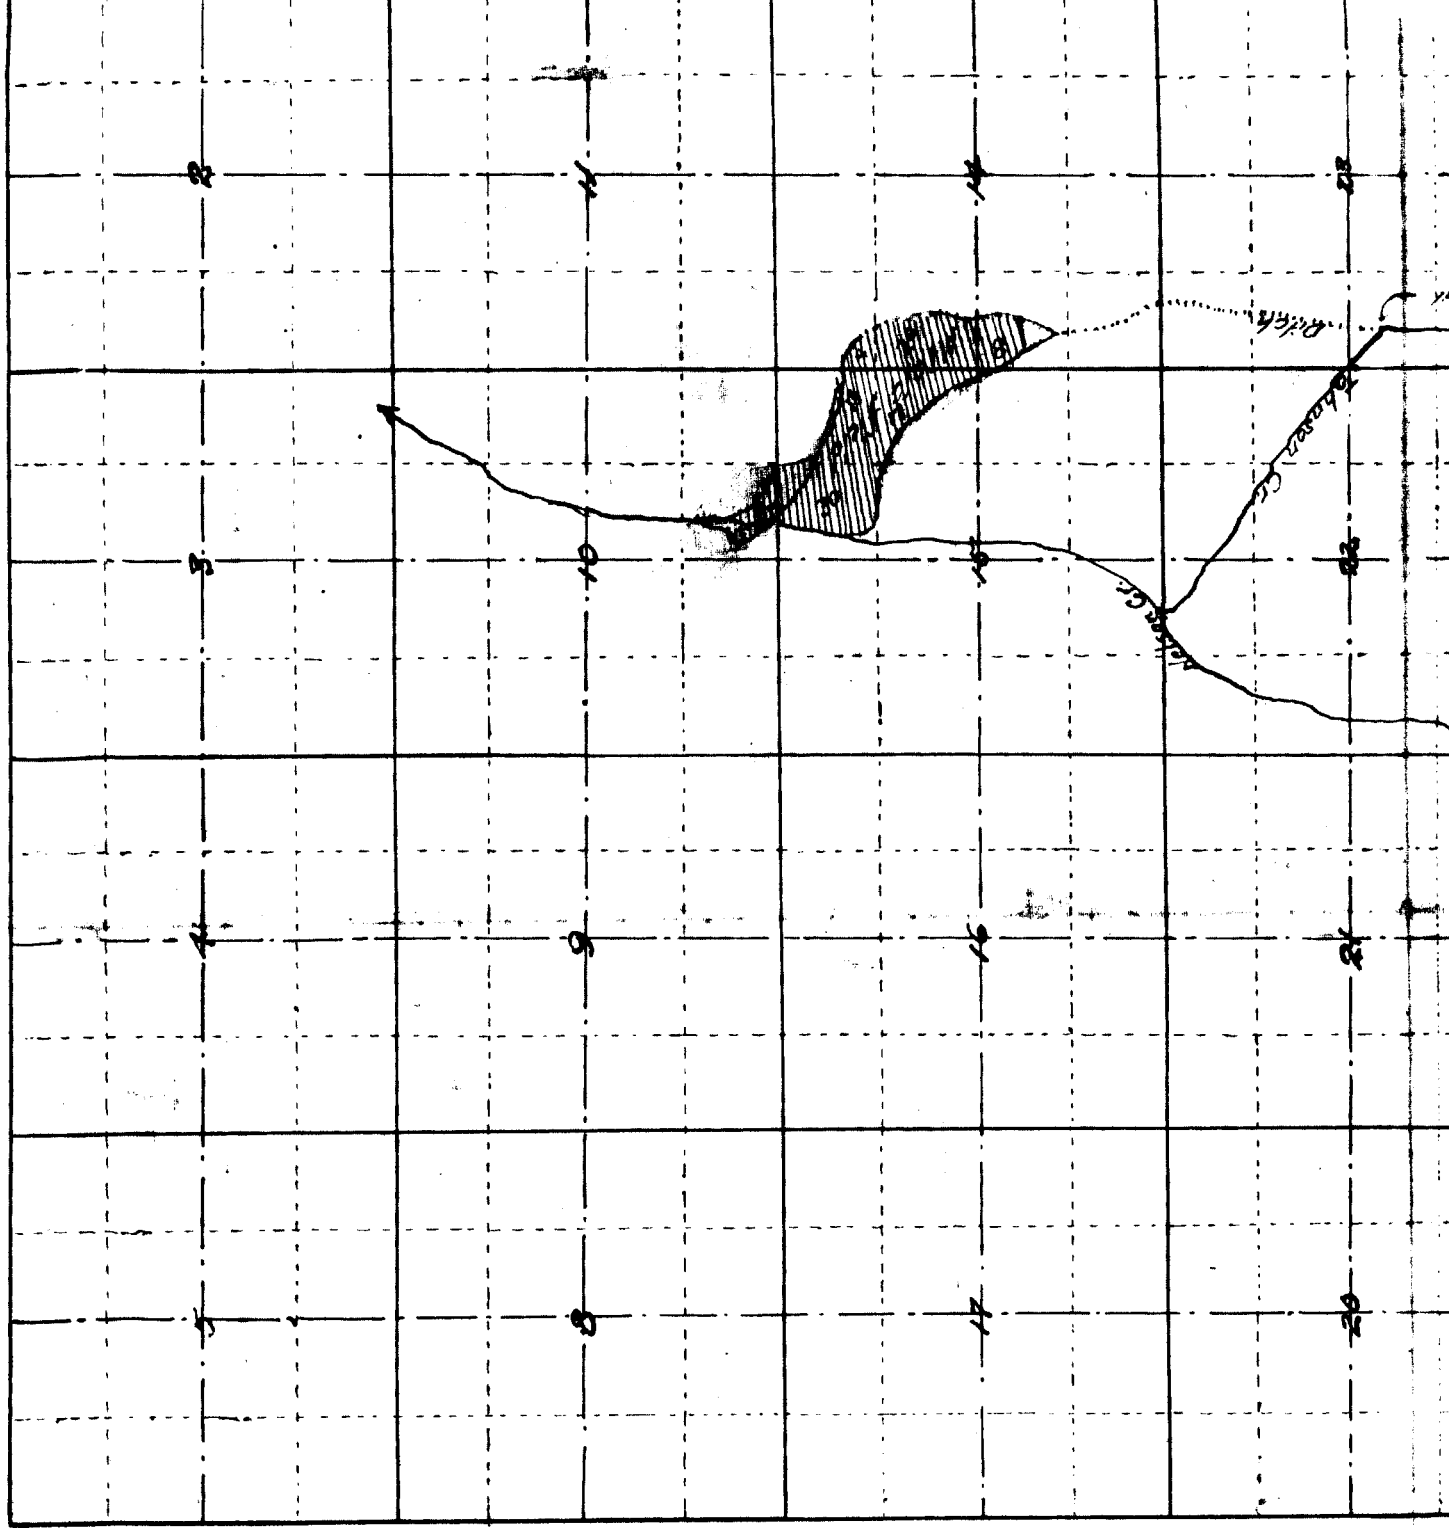

I, Cole of Mitchell, Oregon County
 do hereby certify that this map
 was made from notes taken during an
 survey made by G. A. Peck
 surveyor on the 30th day of
 March, 1928 and that it correctly
 shows the work described in the
 on of stream and other ditches
 immediate vicinity

C. L. Cole

[illegible]