


BOVEE IRRIGATION WORKS

T. 14 S. R. 5 W., W. M.

Scale: 1 in. = 660 feet

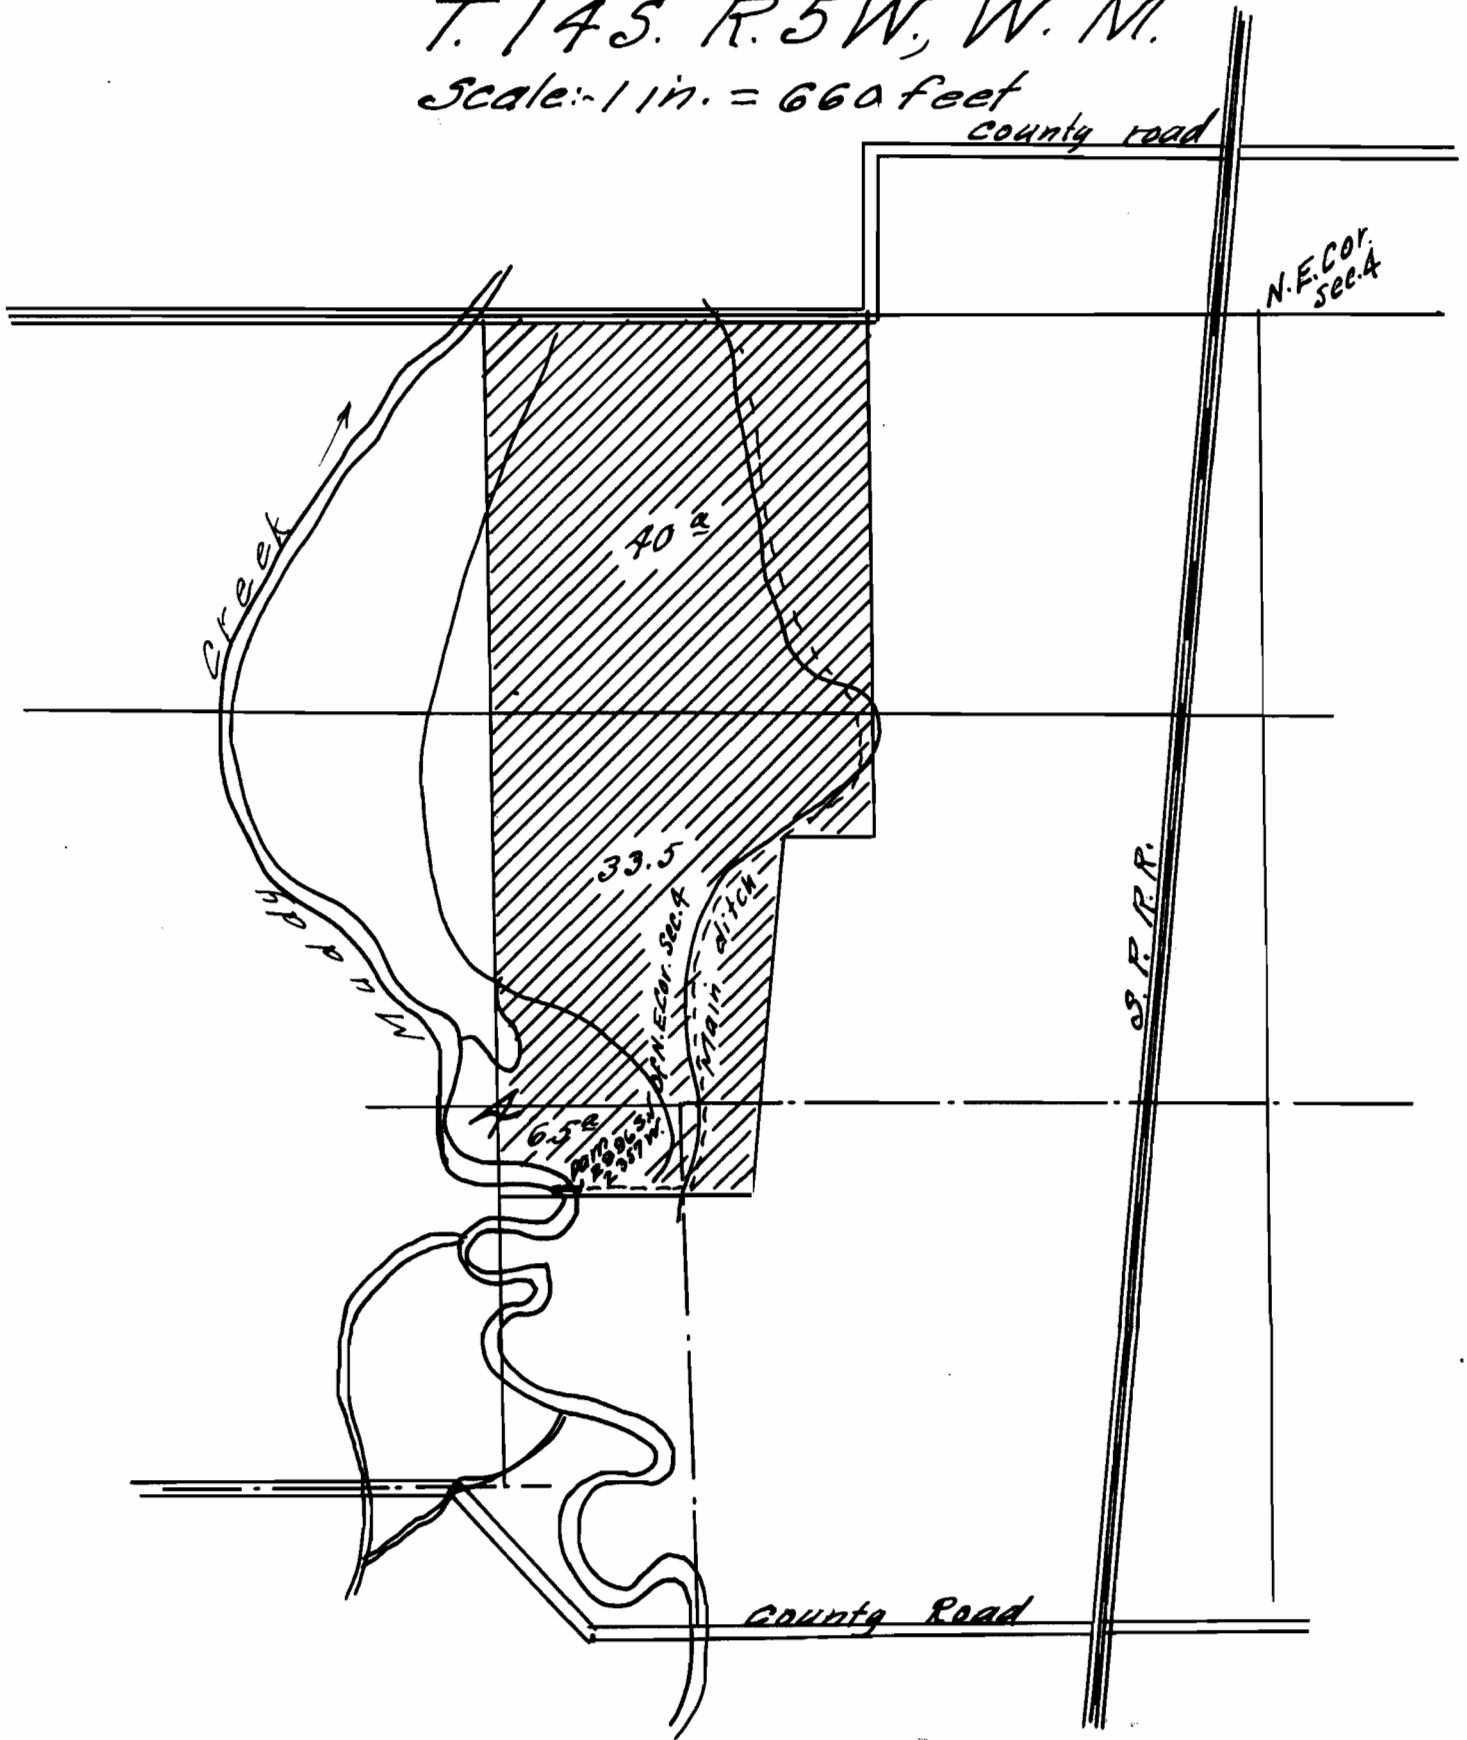

I, Walter W. Larsen, of Corvallis, Ore., do hereby certify that this map was made from notes taken during an actual survey made by me on March 16, 1931, and that it correctly represents the works described in the accompanying application, together with the location of streams and other ditches in the immediate vicinity.

Walter W. Larsen

Registered Professional Engineer

Ore. No. 1261, May 11, 1923

Scale: 1 inch = 10 chains

Application No. 13996

Permit No. 10079