

SECTION


31

P. 10452

11002

TOWNSHIP 85, RANGE 28E, W. M.

North

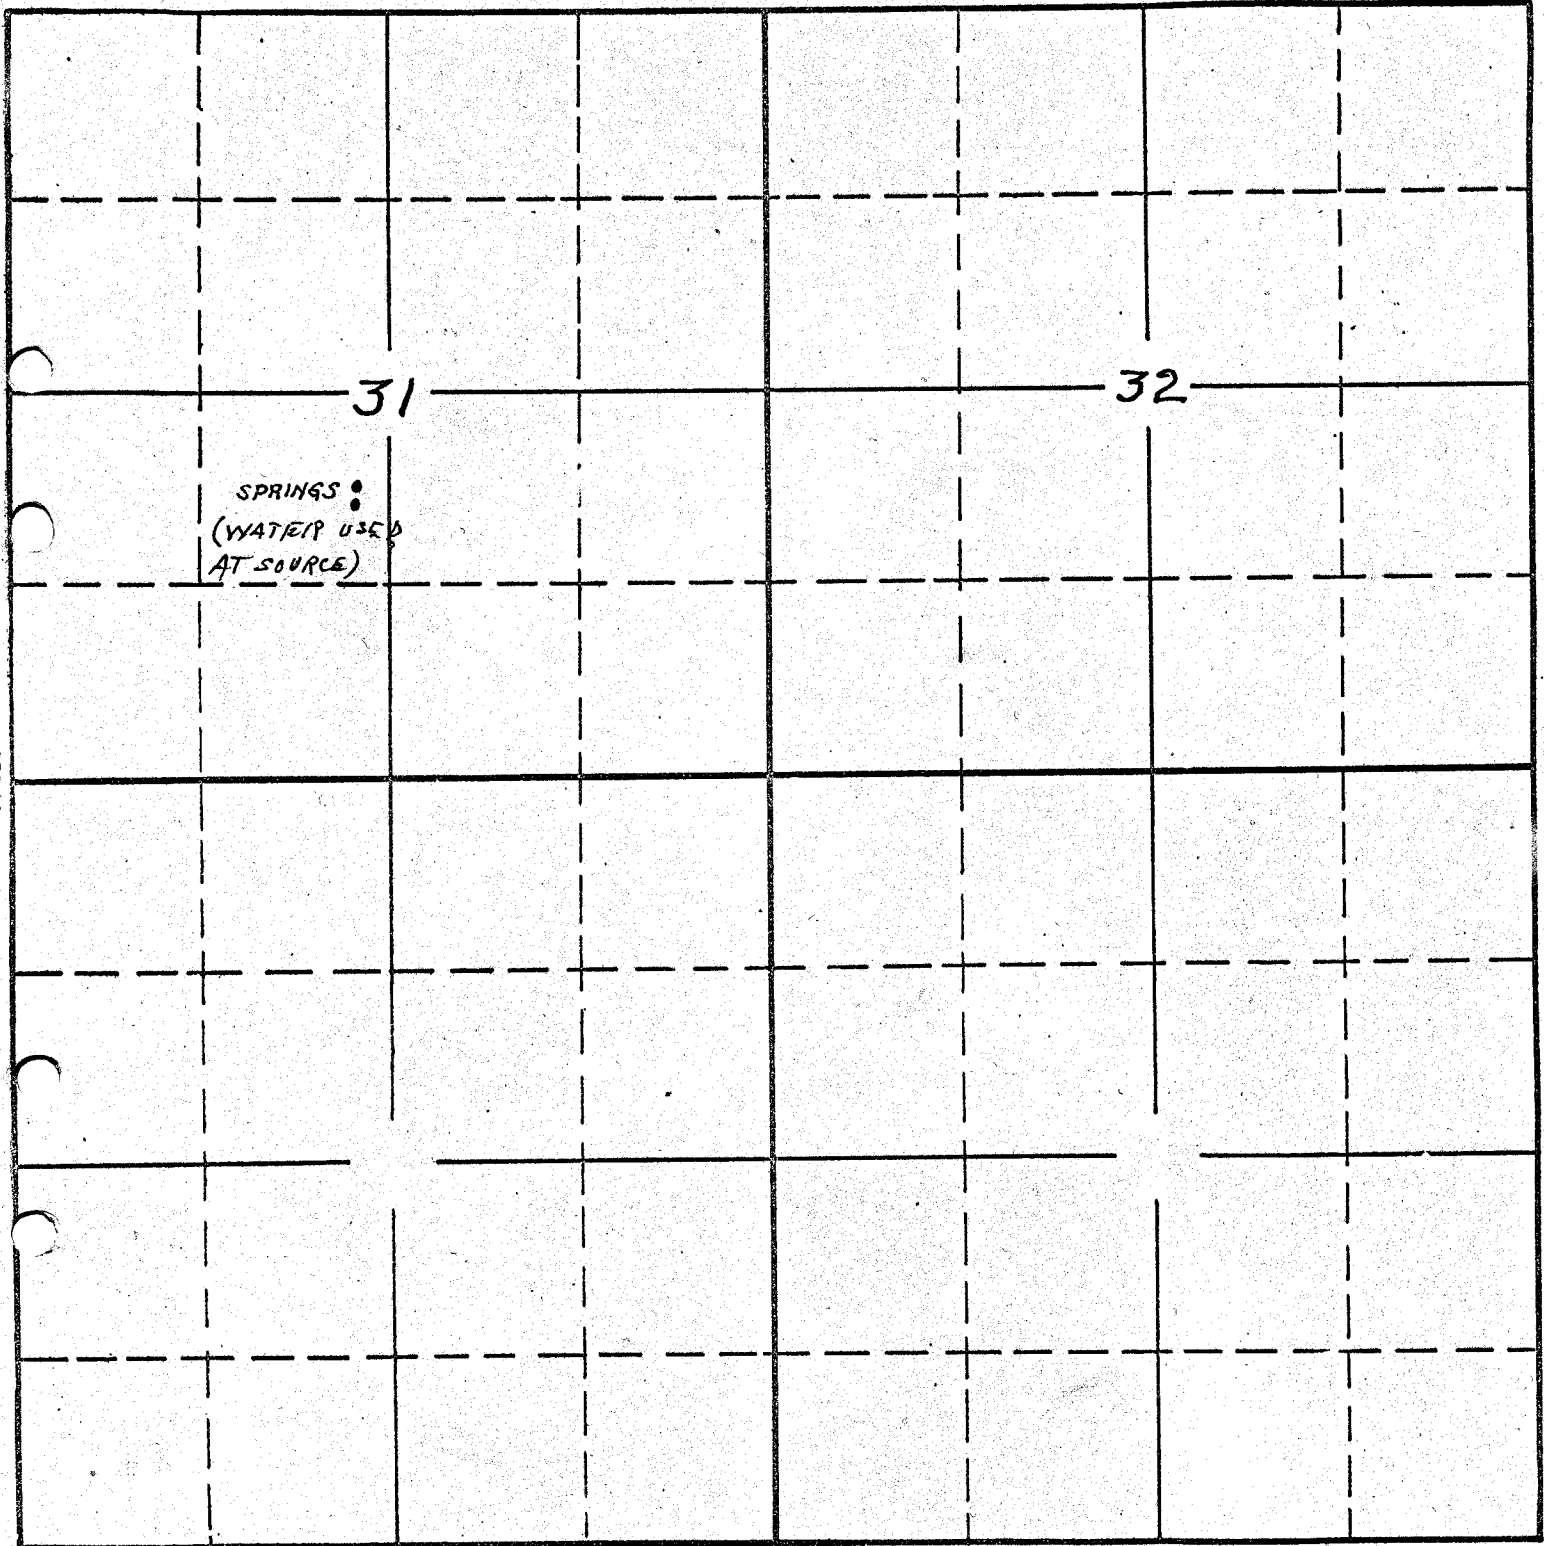

South

APPLICATION No. 14324

PERMIT No. 10452